


Mc Pherson

Map No. **KANSAS** Sec. **29** Twp. **21** R. **1 W**

Well No. **1-~~Hoising~~ Bopchner** Farm
Continental Oil Company

NORTH

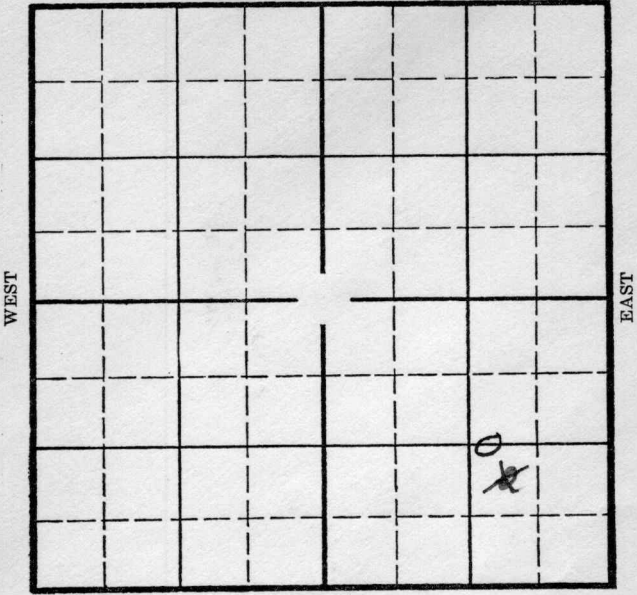

SOUTH

Location _____
Drilling Remarks _____

Rig Up _____
Drilling Remarks _____

RECORD

PRODUCTION

Cased _____ in. _____ ft.
Sand _____
Gas _____
Oil _____
Total Depth _____


1st 24 hrs. Nat. _____
1st 24 hrs. after shot _____
Gas _____ cu. ft. _____
Dry Hole _____
Abandoned _____

Mc Pherson

Map No. KANSAS Sec. 29 Twp. 21 R. 1W

Well No. 1- ~~Geoprog~~ Bochner Farm
Continental Oil Company

1320 Ft. from N. Line
~~990~~ Ft. from S. Line
~~930 990~~ Ft. from E. Line
Ft. from W. Line

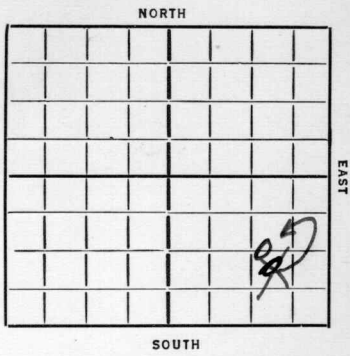

Elevation 1491

REPORT

- ~~1986~~
- 1/29 Call on material
- 2/6 BK
- 2/14 Ru
- 2/21 15" 132 woc
- 2/28 slg 2045
- 3/6 " 2871
- 3/13 T. chat 2920 Base Lime 3138
T. Hunton 3318 7" 3318 T.D. 3320
Show oil. Rust.
- 3/20 T.D. 3335 2600' oil C.O.
- 3/27 Building tanks.
- 4/2 --
- 4/1 Hunton 3318
T.D. 3335
2000 acid
1124 Bbls.

COMPLETED

Map No. 43 Sec. 29 Twp. 21 R. 1^W

Well No. 1-Boering
Continental oil Company

Contractor

FIRST REPORTS

SECTION PLAT

			0

.....Ft. from N. Line

990 Ft. from S. Line

990 Ft. from E. Line

.....Ft. from W. Line

Location.....

Rig up.....

Drilling and Remarks:

Cells + material

RECORD

Cased.....in.,ft.

Sand.....

Gas.....

Oil.....

Total Depth.....

PRODUCTION

1st 24 hrs. Nat.....

1st 24 hrs. after shot.....

Gas.....Cu. Ft.

Dry Hole.....

Abandoned.....

Date

1-29-36 192.....

ORVAL MANNSCHRECK

Scout

McPherson 43
Form 26-1M Bks. 9-28

KANSAS

Map No. 43 Sec. 29 Twp. 21 R. 1W

Well No. 1 - Boechner

Continental etal Company

CORRECTION Contractor

SECTION PLAT

QWL E 1/2 SE

1320 Ft. from N. Line

Ft. from S. Line

930 Ft. from E. Line

Ft. from W. Line

			o

CORRECTION

Location

Rig up

Drilling and Remarks:

Incorrectly reported as being #1 J.C. Goering

990 from So + 990 from east

RECORD

Cased in., ft.

Sand

Gas

Oil

Total Depth

PRODUCTION

1st 24 hrs. Nat.

1st 24 hrs. after shot

Gas Cu. Ft.

Dry Hole

Abandoned

Date

FEB 5 1936

ORVAL MANNSCHRECK

192 Scout

Form 26—1M Dts. 3-23
Mapherson

KANSAS

Map No. 43 Sec. 29 Twp. 21 R. 1W

Well No. 1-Boechner
Continental etal Company

Contractor

COMPLETE

SECTION PLAT

1320 Ft. from N. Line
..... Ft. from S. Line
930 Ft. from E. Line
..... Ft. from W. Line

			0

Location.....

Rig up.....

Drilling and Remarks:

2000 and
1124 bbls

RECORD

Cased..... in., ft.
Sand Huntow 3318
Gas.....
Oil.....
Total Depth 3335

PRODUCTION

1st 24 hrs. Nat.....
1st 24 hrs. after shot.....
Gas..... Cu. Ft.
Dry Hole.....
Abandoned.....

Date

4-1-36 192.....

ORVAL MANNSCHRECK
Scout