


McPherson

Form 51-5M 5-37 Petrol

Section 29 Township 21 Range 1-W

Well No. 4 - Graber

Company Continental et al

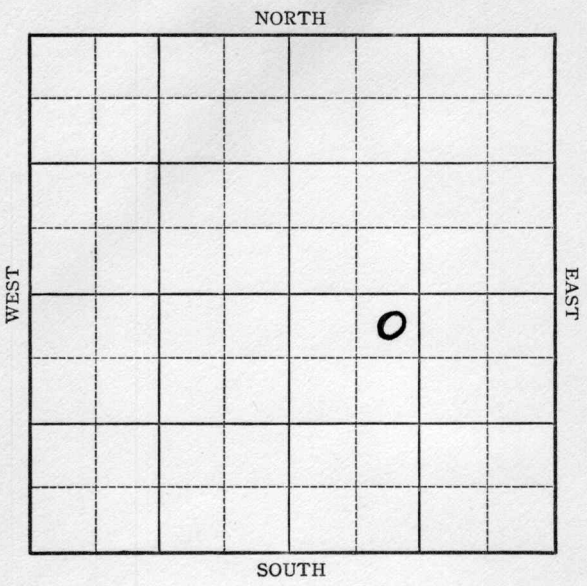

Sec. 29 Twp. 21 R. 1-W

Well No. #4 Graber Farm

Continental et al Company


330 Ft. from N. Line

_____ Ft. from S. Line

_____ Ft. from E. Line

990 Ft. from W. Line

Elev. 1485

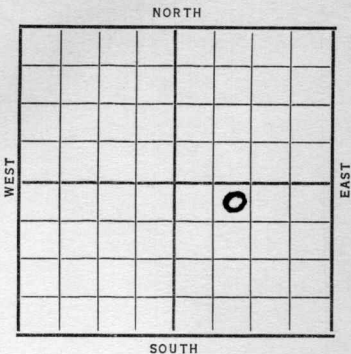

Date	REPORT
1937	
8/4	Location
8/13	Cellar
8/20	R. R.
8/28	10" @ 142'. Drlg. 485'.
9/3	Drlg. 2595'.
9/10	Chat 2934-3090' no shows.
	Hunton 3292'. T.D. 3296'.
	6" @ 3292'. RUST. No shows rep.
9/17	Drlg. 3298'.
9/22	Hunton 3292'.
	T.D. 3335'.
	4000 acid.
	Pump 400 bbls. 24 hrs.
	COMPLETED

KANSAS

McPherson

Form 26—1M Bks.—2-29

Map No. 43 Sec. 29 Twp. 21 R. 1 W

Well No. 4 - Graber

Continental etal Company

Contractor

FIRST REPORT

SECTION PLAT

330 Ft. from N. Line
____ Ft. from S. Line
____ Ft. from E. Line
990 Ft. from W. Line

		0	

Location

Rig up _____

Drilling and Remarks:

RECORD

Cased _____ in., _____ ft.

Sand _____

Gas _____

Oil _____

Total Depth _____

PRODUCTION

1st 24 hrs. Nat. _____

1st 24 hrs. after shot _____

Gas _____ Cu. Ft.

Dry Hole _____

Abandoned _____

Date

AUG 4 - 1937
19

H. D. Hatfield

Scout

Mephuson

Map No. 43 Sec. 29 Twp. 21 R. 1W

Well No. 4-Graber

Continental oil Company

Contractor _____

SECTION PLAT

330 Ft. from N. Line

_____ Ft. from S. Line

_____ Ft. from E. Line

990 Ft. from W. Line

		0	

COMPLETED

RECORD

Location _____

Cased _____ in., _____ ft.

Rig up _____

Sand Huntow 3292

Drilling and Remarks:

Gas _____

4000 acid

Oil _____

Total Depth 3335

PRODUCTION

Pump 400 bbls
24 hrs.

1st 24 hrs. Nat. _____

1st 24 hrs. after shot _____

Gas _____ Cu. Ft.

Dry Hole _____

Abandoned _____

Date

SEP 22 1937