


Section 29 Township 21 Range 1-W

Well No. 5 Graber


Company Continental et al

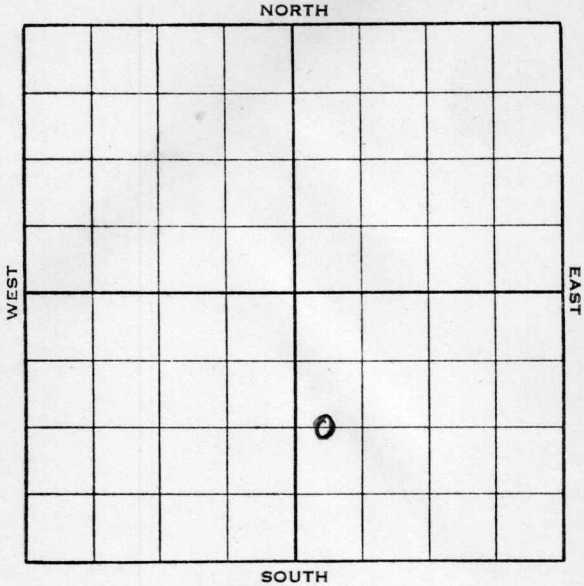

Sec. 29 Twp. 21 R. 1-W

Well No. #5 Graber Farm  
Continental et al Company

         Ft. from N. Line  
1320 Ft. from S. Line  
         Ft. from E. Line  
330 Ft. from W. Line  
 Elev. 1482

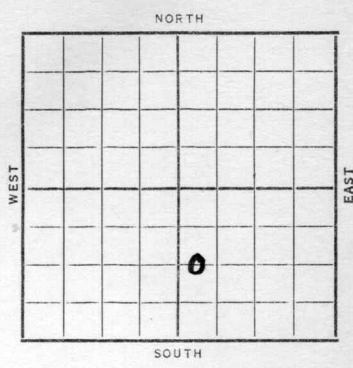

Date	REPORT
1938	
3/16	Location
3/25	"
4/1	"
4/8	Rng. 10" @ 160'.
4/15	10" @ 159'. Drlg. 1320'.
4/22	Chat 2920'. Drlg. 3175'.
4/29	Hunton 3292-94' T.D.
5/6	7" @ 3293'. RUST.
	T.D. 3330'. 6000 acid.
5/10	7" @ 3293'.
	Hunton 3292'.
	T.D. 3330'.
	6000 acid.
	Potential 213 oil & 30 water.
	COMPLETED

Map No. 43 Sec. 29 Twp. 21 R. 1W

Well No. 5 Graber

Continental etal Company

Contractor

**FIRST REPORT**  
C W L S E

**SECTION PLAT**

		○	

\_\_\_\_\_ Ft. from N. Line

1320 Ft. from S. Line

\_\_\_\_\_ Ft. from E. Line

330 Ft. from W. Line

Location X

Rig up \_\_\_\_\_

Drilling and Remarks:

**RECORD**

Cased \_\_\_\_\_ in., \_\_\_\_\_ ft.

Sand \_\_\_\_\_

Gas \_\_\_\_\_

Oil \_\_\_\_\_

Total Depth \_\_\_\_\_

**PRODUCTION**

1st 24 hrs. Nat. \_\_\_\_\_

1st 24 hrs. after shot \_\_\_\_\_

Gas \_\_\_\_\_ Cu. Ft.

Dry Hole \_\_\_\_\_

Abandoned \_\_\_\_\_

Date

MAR 16 1938

19

H. D. Hatfield Scout

Map No. 43 Sec. 29 Twp. 21 R. 1W

Well No. 5 Graber

Continental etal Company

Contractor

COMPLETED

C W L S E

SECTION PLAT

         Ft. from N. Line

1320 Ft. from S. Line

         Ft. from E. Line

330 Ft. from W. Line

		0	

Location                                 

Rig up                                 

Drilling and Remarks:

*6000 acid*

*pot 21 2 oil  
30 wtr*

RECORD

Cased 7 in., 3293 ft.

Sand HUNTON 3292

Gas                                 

Oil                                 

Total Depth 3330

PRODUCTION

1st 24 hrs. Nat.                                 

1st 24 hrs. after shot                                 

Gas                                  Cu. Ft.

Dry Hole                                 

Abandoned                                 

Date

MAY 10 1938 19

H. D. Hatfield Scout