

KANSAS

Map No. _____ Sec. 29 Twp. 21 R. 1-W

Well No. 2 A.K. Graber Farm _____


Continental Oil Company

_____ Ft. from N. Line

1320 Ft. from S. Line

_____ Ft. from E. Line

990 Ft. from W. Line

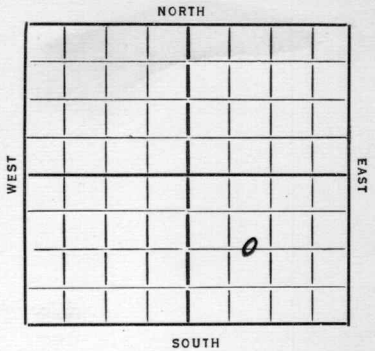

Elev. 1487

Date
1936

REPORT

4/1 Location

4/10 Rigging up.

4/16 Drlg. 170'

4/23 Drlg. 2610'

4/30 7" @ 3306'.

5/7 7" @ 3299' RUST.

5/14 T.D. 3314'. Pay 3304-14'. Swabbed
125 bbls in 2 hours. 2000 acid.

5/20/36- Hunton 3294'.

2000 acid.

T.D. 3314'

813 bbls potential.

COMPLETED

Map No. 43 Sec. 29 Twp. 21 R. 1W


Well No. 2 - A. K. Graber

Continental oil Company

Contractor

FIRST REPORTS

SECTION PLAT

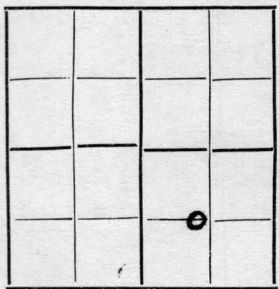

..... Ft. from N. Line

1320 Ft. from S. Line

..... Ft. from E. Line

990 Ft. from W. Line

Location

Rig up

Drilling and Remarks:

RECORD

Cased.....in.,ft.

Sand.....

Gas.....

Oil.....

Total Depth.....

PRODUCTION

1st 24 hrs. Nat.....

1st 24 hrs. after shot.....

Gas.....Cu. Ft.

Dry Hole.....

Abandoned.....

Date

ORVAL MANNSCHRECK

4-1-36 192.....

Scout

Map No. 43 Sec. 29 Twp. 21 R. 1W

Well No. 2 A K Graber

Continental Company

Contractor

SECTION PLAT

_____ Ft. from N. Line

1320 Ft. from S. Line

_____ Ft. from E. Line

990 Ft. from W. Line

COMPLETED

Location _____

Rig up _____

Drilling and Remarks:

Hutton 3294

2000 acid

PO 813 8/4

RECORD

Cased _____ in., _____ ft.

Sand _____

Gas _____

Oil _____

Total Depth 3314

PRODUCTION

1st 24 hrs. Nat. _____

1st 24 hrs. after shot _____

Gas _____ Cu. Ft.

Dry Hole _____

Abandoned _____

Date

MAY 20 1936

19

S. J. LEWIS Scout