


McPherson

Section 29 Township 21 Range 1-W

Well No. 7 - Hetzke

Company Continental et al

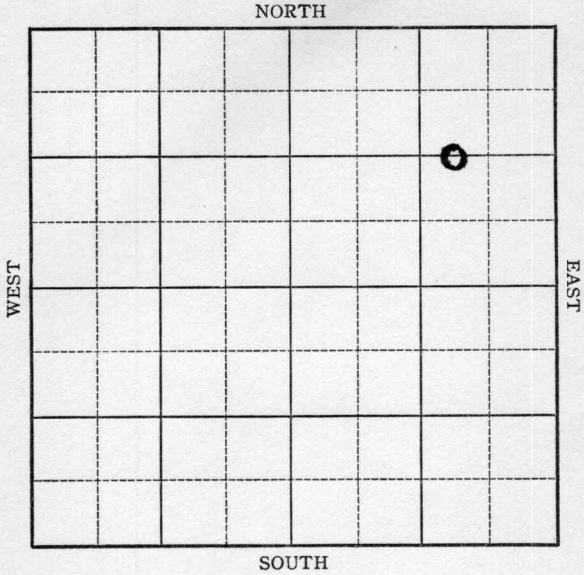

Sec. 29 Twp. 21 R. 1-W

Well No. #7 Hetzke Farm


Continental et al Company

1320 Ft. from N. Line

_____ Ft. from S. Line

990 Ft. from E. Line

_____ Ft. from W. Line

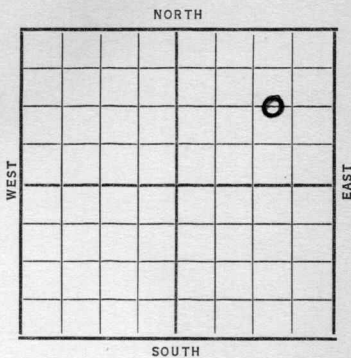

Date	REPORT
1937	
6/2	B. R. R.
6/11	10" @ 158'. Drlg. 1500'.
6/19	Chat 2923'. Drlg. 2930'.
6/25	Hunton 3286'. 7" @ 3287'.
	RUST.
7/2	T.D. 3320'. 2700' oil.
7/9	" " " "
7/16	" " " "
7/23	" " " "
7/30	" " " "
8/6	" " " "
8/11	7" @ 3287'.
	Hunton 3286'.
	T.D. 3320'.
	4000 acid.
	Pot. 756 bbls.
	COMPLETED

KANSAS *McPherson*

Map No. 43 Sec. 29 Twp. 21 R. 1 W

Well No. 7-Hetzke

Continental etal Company

Contractor

FIRST REPORT

SECTION PLAT

			o

1320 Ft. from N. Line

 Ft. from S. Line

990 Ft. from E. Line

 Ft. from W. Line

Location _____

Rig up _____

Drilling and Remarks:

B.R.R.

RECORD

Cased _____ in., _____ ft.

Sand _____

Gas _____

Oil _____

Total Depth _____

PRODUCTION

1st 24 hrs. Nat. _____

1st 24 hrs. after shot _____

Gas _____ Cu. Ft.

Dry Hole _____

Abandoned _____

Date

JUN 2 1937

McPherson KANSAS

Map No. _____ Sec. 29 Twp. 21 R. 1 ^W

Well No. 7 - Hetzke

Continental etal Company

Contractor _____

COMPLETED

SECTION PLAT

1320 Ft. from N. Line

_____ Ft. from S. Line

990 Ft. from E. Line

_____ Ft. from W. Line

			0

Location _____

Rig up _____

Drilling and Remarks:

4000 Acid

Pat - 756

RECORD

Cased 7 in., 3287 ft.

Sand Hutton 3286

Gas _____

Oil _____

Total Depth 3320

PRODUCTION

1st 24 hrs. Nat. _____

1st 24 hrs. after shot _____

Gas _____ Cu. Ft.

Dry Hole _____

Abandoned _____

Date

AUG 11 1937 19

H. D. Hatfield

Scout