


Section..... 29 ..... Township..... 21 ..... Range..... 1-W .....

Well Number..... 8 - Hetzke .....


Company..... Continental et al .....

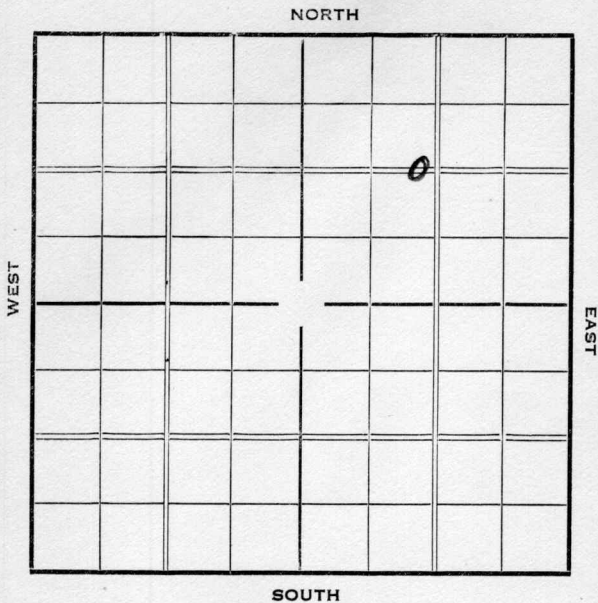

Sec. 29 Twp. 21 R. 1-W

Well No. #8 Hetzke Farm  
Continental et al Company

1320 Ft. from N. Line  
 \_\_\_\_\_ Ft. from S. Line  
 \_\_\_\_\_ Ft. from E. Line  
990 Ft. from W. Line

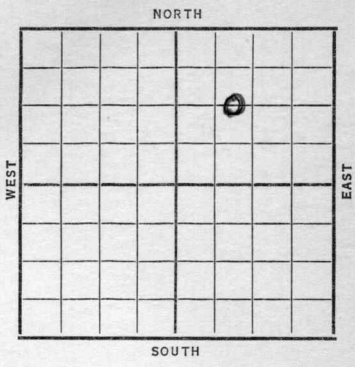

Date	REPORT
1937	
7/14	R. R.
7/23	10" @ 140'. Drlg. 1780'.
7/30	Drlg. 2870'.
8/6	Hunton 3282'. 7" @ 3283'. T.D. 3286'. RUST.
8/13	" " "
8/18	7" @ 3283'. Hunton 3282'. T.D. 3326'. 4000 acid. Pot. 752 bbls.
COMPLETED	

KANSAS *Mc Pherson*

Map No. \_\_\_\_\_ Sec. *29* Twp. *21* R. *1W*

Well No. *S-Hetake*

*Continental etal* Company

Contractor \_\_\_\_\_

FIRST REPORT

*1320* Ft. from N. Line  
\_\_\_\_ Ft. from S. Line  
\_\_\_\_ Ft. from E. Line  
*990* Ft. from W. Line

SECTION PLAT

		o	

Location \_\_\_\_\_

Rig up \_\_\_\_\_

Drilling and Remarks:

*R.R.*

RECORD

Cased \_\_\_\_\_ in., \_\_\_\_\_ ft.  
Sand \_\_\_\_\_  
Gas \_\_\_\_\_  
Oil \_\_\_\_\_  
Total Depth \_\_\_\_\_

PRODUCTION

1st 24 hrs. Nat. \_\_\_\_\_  
1st 24 hrs. after shot \_\_\_\_\_  
Gas \_\_\_\_\_ Cu. Ft.  
Dry Hole \_\_\_\_\_  
Abandoned \_\_\_\_\_

Date

*JUL 14 1937* 19 \_\_\_\_\_

*H. D. Hatfield* Scout

*McPherson* KANSAS

Map No. 43 Sec. 29 Twp. 21 R. 1 W

Well No. S. Hetzke

Continental etal Company

Contractor

COMPLETED

SECTION PLAT

1320 Ft. from N. Line

\_\_\_\_\_ Ft. from S. Line

\_\_\_\_\_ Ft. from E. Line

990 Ft. from W. Line

		○	

Location \_\_\_\_\_

Rig up \_\_\_\_\_

Drilling and Remarks:

4000 Acid

Pat - 752

RECORD

Cased 7 in., 3283 ft.

Sand Hurton 3282

Gas \_\_\_\_\_

Oil \_\_\_\_\_

Total Depth 3326

PRODUCTION

1st 24 hrs. Nat. \_\_\_\_\_

1st 24 hrs. after shot \_\_\_\_\_

Gas \_\_\_\_\_ Cu. Ft.

Dry Hole \_\_\_\_\_

Abandoned \_\_\_\_\_

Date

AUG 18 1937 19

H. D. Hatfield Scout