


McPherson

Section 29 Township 21 Range 1-W

Well No. 11 Hetzke

Company Continental et al

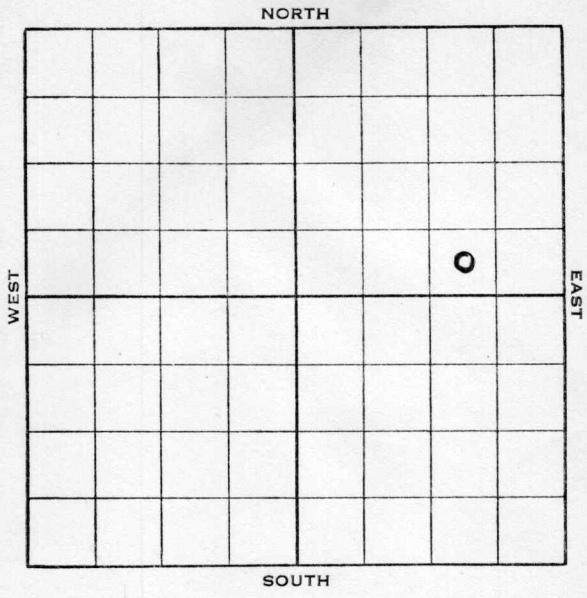

Sec. 29 Twp. 21 R. 1-W

Well No. #11 Hetzke Farm


Continental et al Company

 Ft. from N. Line

330 Ft. from S. Line

990 Ft. from E. Line

 Ft. from W. Line

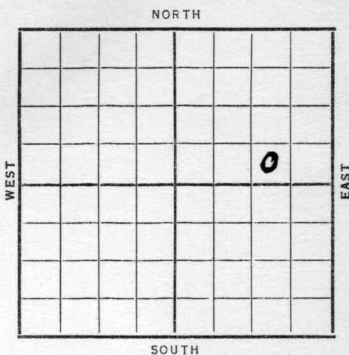

Elev. 1488'

Date	REPORT
1938	
2/2	Location
2/11	B.R.R.
2/18	10" @ 147'. WOC.
2/26	Drlg. 2443'.
3/4	Chat 2925-3045'. Drlg. 3245'.
3/11	Hunton 3298'. 7" @ 3299'.
	Drlg. 3313' S.O.
3/16	7" @ 3299'.
	Hunton 3298'.
	T.D. 3338'.
	4000 acid.
	Potential 481 bbls.
	COMPLETED

Map No. 43 Sec. 29 Twp. 21 R. 1W

Well No. 11 Hetzke

Continental etal Company

Contractor

FIRST REPORT

SECTION PLAT

SW SE NE
 _____ Ft. from N. Line
330 Ft. from S. Line
990 Ft. from E. Line
 _____ Ft. from W. Line

			0

Location X

Rig up _____

Drilling and Remarks:

RECORD

Cased _____ in., _____ ft.

Sand _____

Gas _____

Oil _____

Total Depth _____

PRODUCTION

1st 24 hrs. Nat. _____

1st 24 hrs. after shot _____

Gas _____ Cu. Ft.

Dry Hole _____

Abandoned _____

Date

FEB 2 1938 19

H. D. Hatfield Scout

