


McPherson

Section 29 Township 21 Range 1W

Well Number #2"A" Hetzke

Company Continental et al

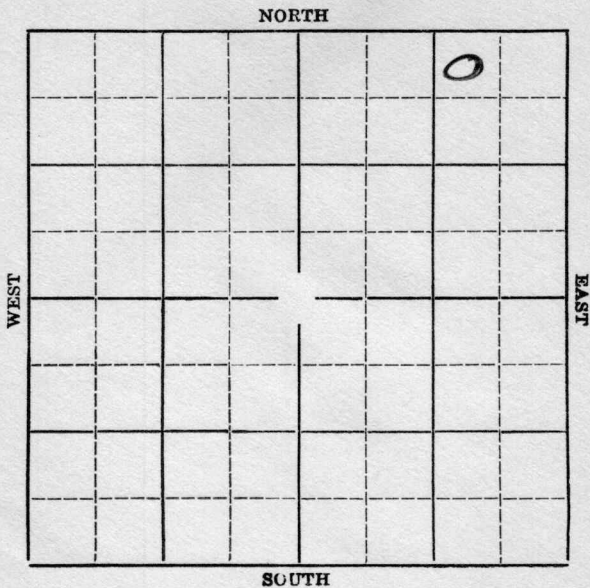

Map No. **KANSAS** Sec. **29** Twp. **21** R. **1W**

Well No. **#2"A" Hetzke** Farm

Continental et al Company


330' Ft. from N. Line

_____ Ft. from S. Line

990' Ft. from E. Line

_____ Ft. from W. Line

Elev. 1476

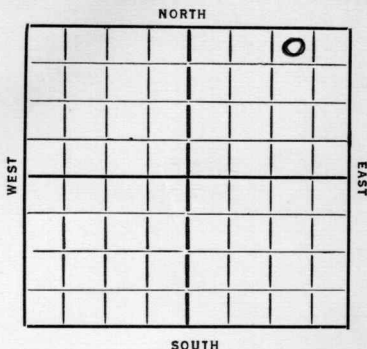

Date	REPORT
1936	
5/27	Location
6/4	12" @ 131'. T.D. 141'. W.O.C.
6/11	Drlg. 2184'.
6/18	Chat 2914'. Drlg. 2915'.
6/25	Drlg. 3145'.
7/2	Hunton 3291'. 7" @ 3293'. W.O.C.
7/9	T.D. 3311'. T.D. 3304' W.O.C. Swabbed 127 bbls of oil in 2 hours.
7/16	4000 gallons of acid.
7/22/36	-Hunton 3291'. T.D. 3311'. 4000 gallons of acid. Potential 1629 bbls.
	COMPLETED

KANSAS.

Map No. 43 Sec. 29 Twp. 21 R. W

Well No. 2 A Hetcher

Continental & Co Company

Contractor

SECTION PLAT

			o

330 Ft. from N. Line

_____ Ft. from S. Line

990 Ft. from E. Line

_____ Ft. from W. Line

FIRST REPORT

Location ✓

Rig up _____

Drilling and Remarks:

RECORD

Cased _____ in., _____ ft.

Sand _____

Gas _____

Oil _____

Total Depth _____

PRODUCTION

1st 24 hrs. Nat. _____

1st 24 hrs. after shot _____

Gas _____ Cu. Ft.

Dry Hole _____

Abandoned _____

Date

MAY 27 1936

19

S. J. LEWIS

Scout

Map No. 43 Sec. 29 Twp. 21 R. 1W

Well No. 2 "A" Hetsko

Continental & Co Company

Contractor

SECTION PLAT

			0

330 Ft. from N. Line

_____ Ft. from S. Line

990 Ft. from E. Line

_____ Ft. from W. Line

COMPLETED

Location _____

Rig up _____

Drilling and Remarks:

*Hanton 3291.
4000 acid
P 81629.*

RECORD

Cased _____ in., _____ ft.

Sand _____

Gas _____

Oil _____

Total Depth 3311

PRODUCTION

1st 24 hrs. Nat. _____

1st 24 hrs. after shot _____

Gas _____ Cu. Ft.

Dry Hole _____

Abandoned _____

Date

JUL 22 1936 19

S. J. LEWIS

Scout