


MCPHERSON

Form 51-5M-3-35-Mid-West

Map No. KANSAS Sec. 29 Twp. 21 R. 1-W

Well No. 1-Huntsman Farm  
Continental et al Company

NORTH

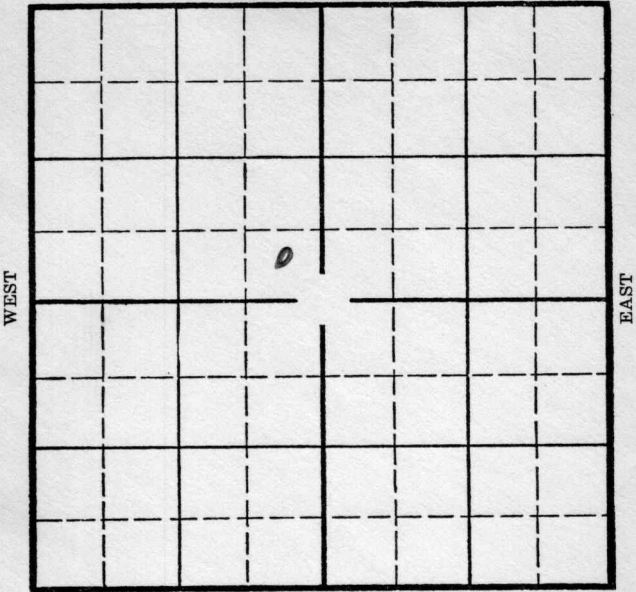

SOUTH

Location \_\_\_\_\_  
Drilling Remarks \_\_\_\_\_

Rig Up \_\_\_\_\_  
Drilling Remarks \_\_\_\_\_

\_\_\_\_\_  
 \_\_\_\_\_  
RECORD

PRODUCTION

Cased \_\_\_\_\_ in. \_\_\_\_\_ ft.  
 Sand \_\_\_\_\_  
 Gas \_\_\_\_\_  
 Oil \_\_\_\_\_  
 Total Depth \_\_\_\_\_

1st 24 hrs. Nat. \_\_\_\_\_  
 1st 24 hrs. after shot \_\_\_\_\_  
 Gas \_\_\_\_\_ cu. ft. \_\_\_\_\_  
 Dry Hole \_\_\_\_\_  
 Abandoned \_\_\_\_\_

*Mc Pherson*

KANSAS

Map No. \_\_\_\_\_ Sec. *29* Twp. *21* R. *1W*

Well No. *1- Huntsman* Farm \_\_\_\_\_

*Continental Oil*

Company \_\_\_\_\_

\_\_\_\_\_ Ft. from N. Line

*330*


Ft. from S. Line

*330*

Ft. from E. Line

\_\_\_\_\_ Ft. from W. Line

Elev. 1462

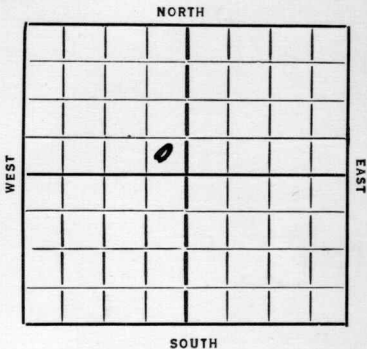

REPORT

*1936*

*3/11*

*Location*

*3/13*

*--*

*3/20*

*Digging ponds.*

*3/27*

*Spud.*

*4/2*

*20"-21' 15"- 126' Drlg. 2337'*

*4/10*

*Chat 2910'-7"@ 3272'*

*4/16*

*R.U.S.T.*

*4/23*

*Drlg. 3276'-3000' oil in hole.*

*4/30*

*2000 acid. Pump 246 bbls. in 2 hrs.*

*5/6/36*

*Chat 2910'*

*T.D. 3276'*

*2000 acid.*

*1476 bbls.*

COMPLETED

KANSAS

Map No. 43 Sec. 29 Twp. 21 R. 1W

Well No. 1-Huntsman

Continental etal Company

Contractor

FIRST REPORTS

SECTION PLAT

.....Ft. from N. Line

330 Ft. from S. Line

330 Ft. from E. Line

.....Ft. from W. Line

	0		

Location

Rig up.....

Drilling and Remarks:

RECORD

Cased.....in., .....ft.

Sand.....

Gas.....

Oil.....

Total Depth.....

PRODUCTION

1st 24 hrs. Nat.....

1st 24 hrs. after shot.....

Gas.....Cu. Ft.

Dry Hole.....

Abandoned.....

Date

3-11-36 192.....

ORVAL MANNSCHRECK

Scout

Map No. 43 Sec. 29 Twp. 21 R. 1W

Well No. 1 Huntsman

Continental Company

Contractor

SECTION PLAT


\_\_\_\_\_ Ft. from N. Line

330 Ft. from S. Line

330 Ft. from E. Line

\_\_\_\_\_ Ft. from W. Line

COMPLETED

Location \_\_\_\_\_

Rig up \_\_\_\_\_

Drilling and Remarks:

Chas 2910

2000 acid

1476 yds.

RECORD

Cased \_\_\_\_\_ in., \_\_\_\_\_ ft.

Sand \_\_\_\_\_

Gas \_\_\_\_\_

Oil \_\_\_\_\_

Total Depth 3276

PRODUCTION

1st 24 hrs. Nat. \_\_\_\_\_

1st 24 hrs. after shot \_\_\_\_\_

Gas \_\_\_\_\_ Cu. Ft.

Dry Hole \_\_\_\_\_

Abandoned \_\_\_\_\_

Date

MAY 6 1936

19

S. J. LEWIS Scout