


Section 29 Township 21 Range 1-W

Well Number 2 Huxman

Company Continental

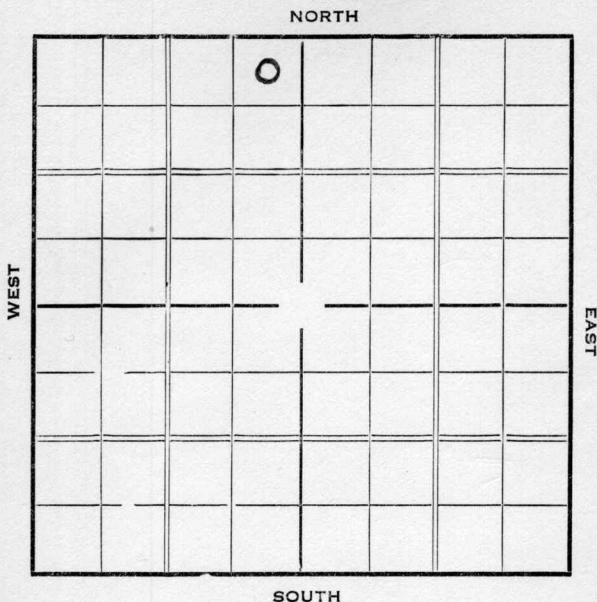

Sec. 29 Twp. 21 R. 1-W

Well No. 2 Huxman Farm

Continental Company


330 Ft. from N. Line

_____ Ft. from S. Line

330 Ft. from E. Line

_____ Ft. from W. Line

Elev. 1479

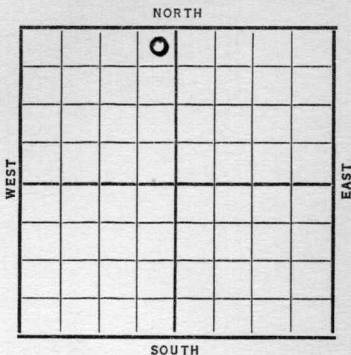

Date	REPORT
1937	
4/28	Location
5/7	Rig
5/14	10" @ 137'. Drlg. 1820'.
5/21	Drlg. 2640'.
5/28	Hunton 3275-77'.
	7" @ 3275'. RUST.
6/4	" " "
6/11	T.D. 3323'. 1500' oil.
	4000 acid.
6/16	7" @ 3275'.
	Hunton 3275'.
	T.D. 3323'.
	4000 A.
	Pot. 644 bbls.
	COMPLETED

McPherson KANSAS

Map No. _____ Sec. 29 Twp. 21 R. 1 W

Well No. 2 - Husman
Continental Company

Contractor _____

FIRST REPORT

SECTION PLAT

		0	

330 Ft. from N. Line

_____ Ft. from S. Line

330 Ft. from E. Line

_____ Ft. from W. Line

Location

Rig up _____

Drilling and Remarks:

RECORD

Cased _____ in., _____ ft.

Sand _____

Gas _____

Oil _____

Total Depth _____

PRODUCTION

1st 24 hrs. Nat. _____

1st 24 hrs. after shot _____

Gas _____ Cu. Ft.

Dry Hole _____

Abandoned _____

Date

APR 28 1887 19

H. D. Hatfield Scout

KANSAS

McPherson

Map No. 43 Sec. 29 Twp. 21 R. 1 W

Well No. 2 - Huxman

Continental Company

Contractor

COMPLETED

SECTION PLAT

330 Ft. from N. Line

_____ Ft. from S. Line

330 Ft. from E. Line

_____ Ft. from W. Line

	0		

Location _____

Rig up _____

Drilling and Remarks:

4000 A

Pat - 644

RECORD

Cased 7 in., 3275 ft.

Sand Hunter 3275

Gas _____

Oil _____

Total Depth 3323

PRODUCTION

1st 24 hrs. Nat. _____

1st 24 hrs. after shot _____

Gas _____ Cu. Ft.

Dry Hole _____

Abandoned _____

Date

JUN 16 1937 19

H. D. Hatfield

Scout