


Section 29 Township 21 Range 1-7

Well No. #2 J. M. Boechner

Company Continental et al

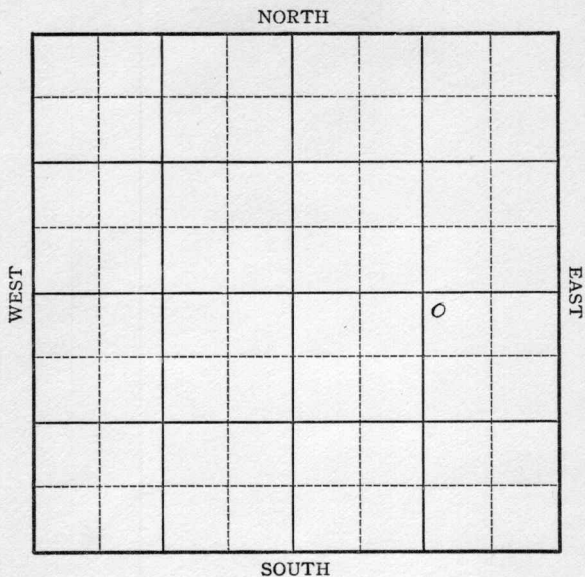

Sec. 29 Twp. 21 R. 1-W


Well No. #2 J. M. Boechner Farm
Continental et al Company

330 Ft. from N. Line

_____ Ft. from S. Line

990 Ft. from E. Line

_____ Ft. from W. Line

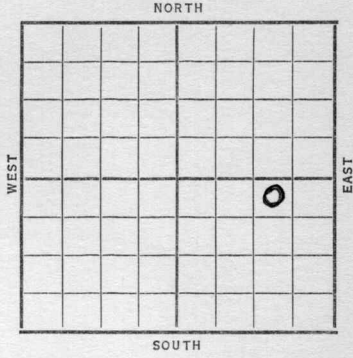

Date	REPORT
1937	
9/29	Location
10/8	Cellar.
10/15	10" @ 143'. WOC.
10/22	Drl g. 2592'.
10/29	Chat 2910'. 6" @ 3279'.
	Hunton 3296'. T.D. 3298'. WOC.
	No shows reported.
11/5	" " "
11/10	6" @ 3279'.
	Hunton 3296'.
	T.D. 3331'.
	4000 acid.
	Potential 643 bbls.
	COMPLETED

Map No. 43 Sec. 29 Twp. 21 R. 1W

Well No. 2-J M Boechner

Continental etal Company

Contractor

FIRST REPORT
NW NE SE

SECTION PLAT

330 Ft. from N. Line

_____ Ft. from S. Line

990 Ft. from E. Line

_____ Ft. from W. Line

			0

Location X

Rig up _____

Drilling and Remarks:

RECORD

Cased _____ in., _____ ft.

Sand _____

Gas _____

Oil _____

Total Depth _____

PRODUCTION

1st 24 hrs. Nat. _____

1st 24 hrs. after shot _____

Gas _____ Cu. Ft.

Dry Hole _____

Abandoned _____

Date

SEP 29 1937 19

H. D. Hatfield Scout

Map No. 43 Sec. 29 Twp. 21 R. 1W

Well No. 2 J.M. Boechner

Continental etal Company

COMPLETED Contractor

SECTION PLAT

NW NE SE

330 Ft. from N. Line

_____ Ft. from S. Line

990 Ft. from E. Line

_____ Ft. from W. Line

			0

Location _____

Rig up _____

Drilling and Remarks:

4000 Acid

POT-643

RECORD

Cased 6 in., 3279 ft.

Sand Hutton 3296

Gas _____

Oil _____

Total Depth 3331

PRODUCTION

1st 24 hrs. Nat. _____

1st 24 hrs. after shot _____

Gas _____ Cu. Ft.

Dry Hole _____

Abandoned _____

Date

NOV 10 1937 19 H. D. Hatfield Scout