


Section 29 Township 21 Range 1-W

Well Number #4 Goering

Company Continental

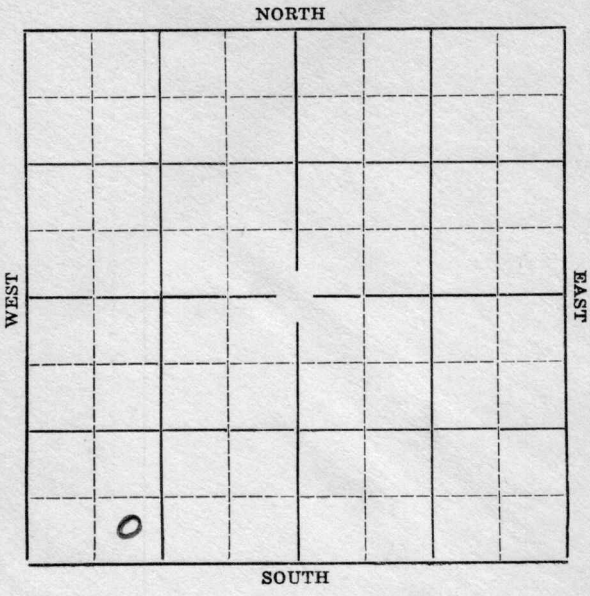

3/13/34

Sec. 29 Twp. 21 R. 1W

Well No. #4 Goering Farm

Continental Company


_____ Ft. from N. Line

330' Ft. from S. Line

_____ Ft. from E. Line

990' Ft. from W. Line

Elev. 1457

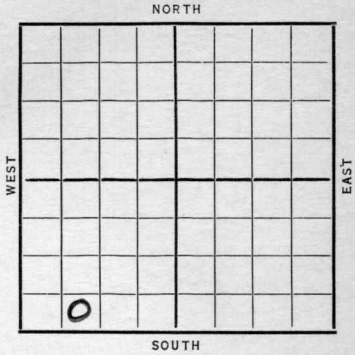

Date	REPORT
1936 10/28	Rig.
11/6	13" @ 147 Drlg. 300
11/12	Drlg. 2610
11/19	Chat 2903'. Drlg. 3240'.
11/27	Hunton 3250'. 7" @ 3252'. Rust.
12/3	Pay 3252-73'. T. D. Swabb 22 bbls. per hour.
12/9	Hunton 3250'. T. D. 3273'. 4000 acid. Pot. 948!
	COMPLETED

Map No. 43 Sec. 29 Twp. 21 R. 1W

Well No. 4 Goering

Continental Company

Contractor

SECTION PLAT

 Ft. from N. Line

330 Ft. from S. Line

 Ft. from E. Line

990 Ft. from W. Line

0

FIRST REPORT

Location _____

Rig up _____

Drilling and Remarks:

Rig

RECORD

Cased _____ in., _____ ft.

Sand _____

Gas _____

Oil _____

Total Depth _____

PRODUCTION

1st 24 hrs. Nat. _____

1st 24 hrs. after shot _____

Gas _____ Cu. Ft.

Dry Hole _____

Abandoned _____

Date

OCT 28 1936 19 _____

S. J. LEWIS Scout

KANSAS

Map No. 43 Sec. 29 Twp. 21 R. 1W

Well No. H Goering

Continental Company

Contractor

SECTION PLAT

_____ Ft. from N. Line

330 Ft. from S. Line

_____ Ft. from E. Line

990 Ft. from W. Line

COMPLETED

Location _____

Rig up _____

Drilling and Remarks:

Huxton 3250

4000 acid

P 8948

RECORD

Cased _____ in., _____ ft.

Sand _____

Gas _____

Oil _____

Total Depth 3273

PRODUCTION

1st 24 hrs. Nat. _____

1st 24 hrs. after shot _____

Gas _____ Cu. Ft.

Dry Hole _____

Abandoned _____

Date

DEC 9 1936 19

S. J. LEWIS

Scout