


Section 29 Township 21- Range 1-W

Well Number 5- Goering

Company Continental et al

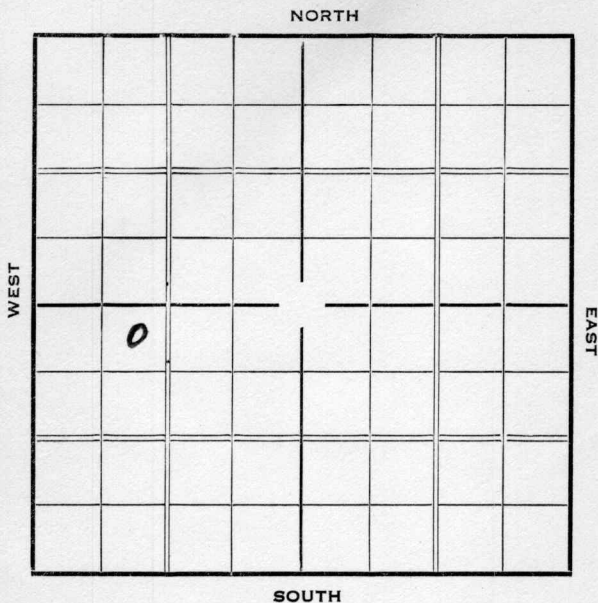

Sec. 29 Twp. 21 R. 1-W

Well No. #5 Goering Farm


Continental et al Company

330 Ft. from N. Line

_____ Ft. from S. Line

_____ Ft. from E. Line

990 Ft. from W. Line

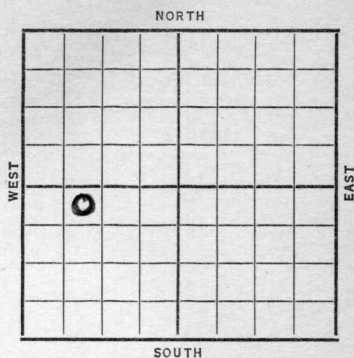

Date	REPORT
1937	
7/14	B. R. R.
7/23	10" @ 140'. Drlg. 1225'.
7/30	Chat 2919'. Drlg. 3005'.
8/6	Hunton 3252'. 6" @ 3253'.
	T.D. 3254'. WOC.
8/13	" " "
8/20	Pay 3253-78'. Base
	Hunton 3296'. T.D. 3297'.
	2500' oil. 4000 acid.
8/25	6" @ 3253'
	Hunton 3252'
	TD 3297'
	4000 acid
	Pot 708
	COMPLETED

McPherson
KANSAS

Map No. 43 Sec. 29 Twp. 21 R. W

Well No. 5 - Goering

Continental etal Company

Contractor

FIRST REPORT

SECTION PLAT

330 Ft. from N. Line
60 Ft. from S. Line
_____ Ft. from E. Line
990 Ft. from W. Line

0			

Location _____

Rig up _____

Drilling and Remarks:

BRR,

RECORD

Cased _____ in., _____ ft.

Sand _____

Gas _____

Oil _____

Total Depth _____

PRODUCTION

1st 24 hrs. Nat. _____

1st 24 hrs. after shot _____

Gas _____ Cu. Ft.

Dry Hole _____

Abandoned _____

Date

JUL 14 1937 19

H. D. Hatfield Scout

KANSAS McPherson

Map No. 43 Sec. 29 Twp. 21 R. 1W

Well No. 5-Goering

Continental Petal Company

Contractor

COMPLETED

SECTION PLAT

330 Ft. from N. Line
____ Ft. from S. Line
____ Ft. from E. Line
990 Ft. from W. Line

	0		

Location _____

Rig up _____

Drilling and Remarks:

4000 Acid

Pat - 708

RECORD

Cased 6 in., 3253 ft.

Sand Hunton 3252

Gas _____

Oil _____

Total Depth 3297

PRODUCTION

1st 24 hrs. Nat. _____

1st 24 hrs. after shot _____

Gas _____ Cu. Ft.

Dry Hole _____

Abandoned _____

Date

AUG 25 1937 19

H. D. Hatfield Scout