


Section 29 Township 21 Range 1-W

Well Number #6 Goering

Company Continental et al

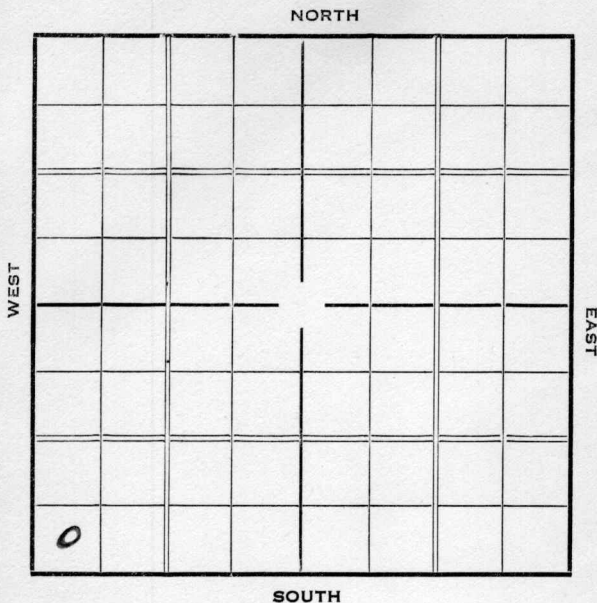

Sec. 29 Twp. 21 R. 1-W

Well No. #6 Goering Farm
Continental et al Company


 Ft. from N. Line

330 Ft. from S. Line

 Ft. from E. Line

330 Ft. from W. Line

Elev. 1464

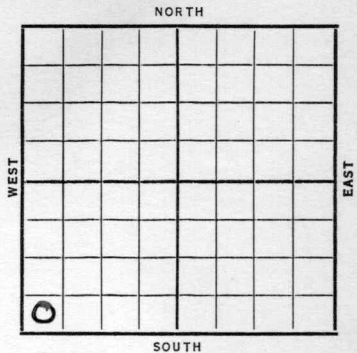

Date	REPORT
1937	
10/13	Location
10/22	"
10/29	B.R.R.
11/5	10" @ 150'. Drlg. 852'.
11/12	Drlg. 3090'.
11/19	Hunton 3255'. 7" @ 3256'.
	T.D. 3260'. RUST.
	No shows Rep.
11/26	T.D. 3279'. 1500' oil.
12/1	7" @ 3256'.
	Hunton 3255'.
	T.D. 3279'.
	4000 acid.
	Potential 542 bbls.
	COMPLETED

McPherson **KANSAS**

Map No. 43 Sec. 29 Twp. 21 R1W

Well No. 6 Goering

Continental etal Company

Contractor

FIRST REPORT

SW/C

 Ft. from N. Line

330 Ft. from S. Line

 Ft. from E. Line

330 Ft. from W. Line

SECTION PLAT

0			

Location X

Rig up

Drilling and Remarks:

RECORD

Cased in., ft.

Sand

Gas

Oil

Total Depth

PRODUCTION

1st 24 hrs. Nat.

1st 24 hrs. after shot

Gas Cu. Ft.

Dry Hole

Abandoned

Date

OCT 13 1937 19

H. D. Hatfield Scout

Map No. 43 Sec. 29 Twp. 21 R. 1W

Well No. 6 Goering

Continental etal Company

Contractor

COMPLETED

SW/C

_____ Ft. from N. Line

330 Ft. from S. Line

_____ Ft. from E. Line

330 Ft. from W. Line

SECTION PLAT

0			

Location _____

Rig up _____

Drilling and Remarks:

4000 acid

POT-542

RECORD

Cased 7 in., 3256 ft.

Sand HUNTON 3255

Gas _____

Oil _____

Total Depth 3279

PRODUCTION

1st 24 hrs. Nat. _____

1st 24 hrs. after shot _____

Gas _____ Cu. Ft.

Dry Hole _____

Abandoned _____

Date

DEC 1 - 1937 19

H. D. Hatfield Scout