


McPherson

Section 29 Township 21 Range 1-W

Well No. 7 Goering

Company Continental

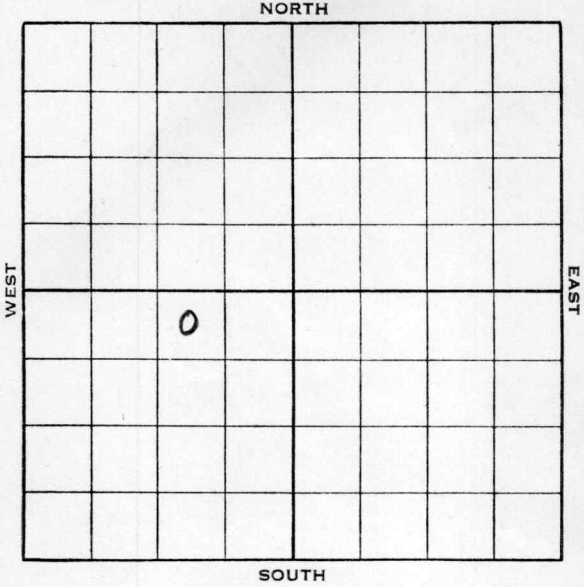

Sec. 29 Twp. 21 R. 1-W

Well No. #7 Goering Farm  
Continental Company


330 Ft. from N. Line

\_\_\_\_\_ Ft. from S. Line

990 Ft. from E. Line

\_\_\_\_\_ Ft. from W. Line

Elev. 1465

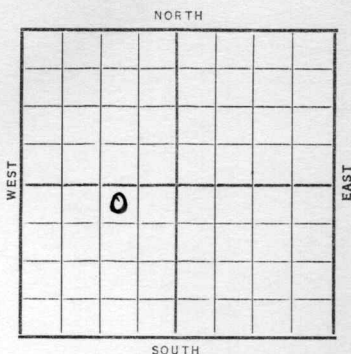

Date	REPORT
1938	
3/16	Location
3/25	"
4/1	"
4/8	R U R
4/15	10" @ 158'. Drlg. 1712'.
4/22	Chat 2900'. Drlg. 2968'.
4/29	Hunton 3251-53' T.D.
	7" @ 3252'. RUST.
5/6	T.D. 3305'. 1600' oil.
5/10	7" @ 3252'.
	Hunton 3251'.
	T.D. 3305'.
	4000 acid.
	Potential 526 bbls.
	COMPLETED

McPherson **KANSAS**

Map No. 43 Sec. 29 Twp. 21 R. 1W

Well No. 7 Goering

Continental Company

FIRST REPORT Contractor

**SECTION PLAT**

	0		

NW NE SW  
330 Ft. from N. Line  
 \_\_\_\_\_ Ft. from S. Line  
990 Ft. from E. Line  
 \_\_\_\_\_ Ft. from W. Line

Location X

Rig up \_\_\_\_\_

Drilling and Remarks:

**RECORD**

Cased \_\_\_\_\_ in., \_\_\_\_\_ ft.  
 Sand \_\_\_\_\_  
 Gas \_\_\_\_\_  
 Oil \_\_\_\_\_  
 Total Depth \_\_\_\_\_

**PRODUCTION**

1st 24 hrs. Nat. \_\_\_\_\_  
 1st 24 hrs. after shot \_\_\_\_\_  
 Gas \_\_\_\_\_ Cu. Ft.  
 Dry Hole \_\_\_\_\_  
 Abandoned \_\_\_\_\_

Date

MAR 16 1938

19

H. D. Hatfield

Scout

Map No. 43 Sec. 29 Twp. 21 R. 1W

Well No. 7 Goering

Continental

Company

Contractor

**COMPLETED**

**SECTION PLAT**

NW NE SW

330 Ft. from N. Line

\_\_\_\_\_ Ft. from S. Line

990 Ft. from E. Line

\_\_\_\_\_ Ft. from W. Line

	0		

Location \_\_\_\_\_

Rig up \_\_\_\_\_

Drilling and Remarks:

*4000 acid*

*pot 526*

**RECORD**

Cased 7 in., 3252 ft.

Sand Hutton 3251

Gas \_\_\_\_\_

Oil \_\_\_\_\_

Total Depth 3305

**PRODUCTION**

1st 24 hrs. Nat. \_\_\_\_\_

1st 24 hrs. after shot \_\_\_\_\_

Gas \_\_\_\_\_ Cu. Ft.

Dry Hole \_\_\_\_\_

Abandoned \_\_\_\_\_

Date

MAY 10 1926

H. D. Hatfield Scout