


Section 29 Township 21 Range 1-W

Well Number 2 J. Goering

Company Continental

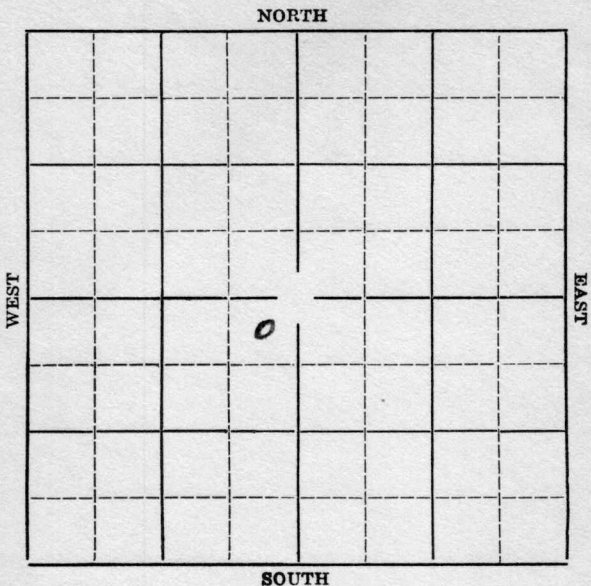

Map No. **KANSAS** Sec. 29 Twp. 21 R. 1-W

Well No. 2 J. Goering Farm \_\_\_\_\_  
 \_\_\_\_\_ Continental \_\_\_\_\_ Company


330 Ft. from N. Line

\_\_\_\_\_ Ft. from S. Line

330 Ft. from E. Line

\_\_\_\_\_ Ft. from W. Line

Elev. 1467

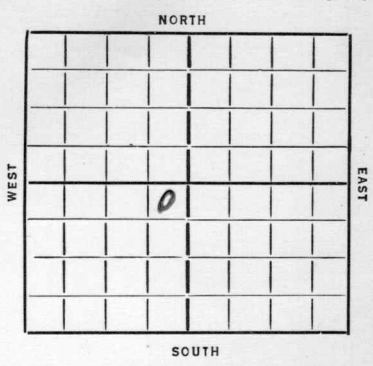

Date  
1936

REPORT

- 4/22 Location
- 4/30 R.O.G.
- 5/7 Spud.
- 5/14 Drlg. 2609'.
- 5/21 Chat 2915'. Hunton 3271' set # 6".  
T.D. 3272'.
- 5/28 Drlg. 3272'. S.O.
- 6/4 --T.D. 3308'-4000 gallons acid.  
469<sup>bbls</sup>-17½ hours.
- 6/10/36- Chat 3215'.  
Total depth 3308'.  
4000 gallons acid.  
572 bbls oil.

**COMPLETED**

*W. Nelson*  
Map No. 43 Sec. 29 Twp. 21 R. 14

Well No. 2 J Goring

Continental Company

Contractor

SECTION PLAT

330 Ft. from N. Line

..... Ft. from S. Line

330 Ft. from E. Line

..... Ft. from W. Line

	0		

FIRST REPORT

Location

Rig up .....

Drilling and Remarks:

RECORD

Cased.....in., .....ft.

Sand .....

Gas .....

Oil .....

Total Depth.....

PRODUCTION

1st 24 hrs. Nat.....

1st 24 hrs. after shot.....

Gas.....Cu. Ft.

Dry Hole.....

Abandoned.....

Date

APR 22 1936 192.....

S. J. LEWIS Scout

Map No. KANSAS Sec. 29 Twp. 21 R. 1W

Well No. 2 Goering

Continental

Company

Contractor

**SECTION PLAT**

	0		

330 Ft. from N. Line

\_\_\_\_\_ Ft. from S. Line

330 Ft. from E. Line

\_\_\_\_\_ Ft. from W. Line

COMPLETED

Location \_\_\_\_\_

Rig up \_\_\_\_\_

Drilling and Remarks:

Chat 8215

4000 acid

572 8 1/2

**RECORD**

Cased \_\_\_\_\_ in., \_\_\_\_\_ ft.

Sand \_\_\_\_\_

Gas \_\_\_\_\_

Oil \_\_\_\_\_

Total Depth 3305

**PRODUCTION**

1st 24 hrs. Nat. \_\_\_\_\_

1st 24 hrs. after shot \_\_\_\_\_

Gas \_\_\_\_\_ Cu. Ft.

Dry Hole \_\_\_\_\_

Abandoned \_\_\_\_\_

Date

JUN 10 1936

19

S. J. LEWIS

Scout