


Mc Pherson

Map No. KANSAS Sec. 29 Twp. 21 R. 1W

Well No. 1- Hitzke Farm _____
Continental et al Company _____

_____ Ft. from N. Line
330 Ft. from S. Line
_____ Ft. from E. Line
330 Ft. from W. Line

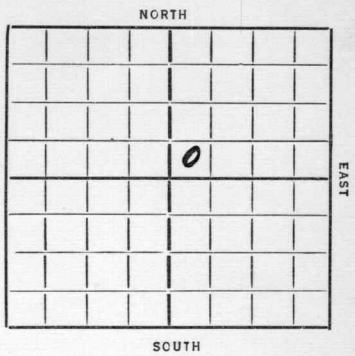

Elev. 1474

REPORT

~~1/22~~
 1/22 Location
 1/31 Rgn
 2/7 Dlg 600 12" 119
 2/14 " 2300
 2/21 " 2937 Chat 2914
 2/28 Periton 3284 TD 3286
 3/6 7" 3284 Sho Oil 3286
 TD 3291 2800' Oil 4 hrs.
 3/18 Periton 3284
 TD 3308
 Pot 1450 Natural

COMPLETED

Map No. 43 Sec. 29 Twp. 21 R. 1W

Well No. 1 - Hetzke

Continental etal Company

Contractor

SECTION PLAT

..... Ft. from N. Line

330 Ft. from S. Line

..... Ft. from E. Line

330 Ft. from W. Line

		0	

FIRST REPORT

Location

Rig up

Drilling and Remarks:

RECORD

Cased..... in., ft.

Sand

Gas

Oil

Total Depth

PRODUCTION

1st 24 hrs. Nat.

1st 24 hrs. after shot

Gas..... Cu. Ft.

Dry Hole

Abandoned

Date

JAN 22 1936 192

Scout

ORVAL MANNSCHECK

Map No. 43 Sec. 29 Twp. 21 R. 1W

Well No. 1 - Hetzke

Continental Company

Contractor

COMPLETED


SECTION PLAT

..... Ft. from N. Line

330 Ft. from S. Line

..... Ft. from E. Line

330 Ft. from W. Line

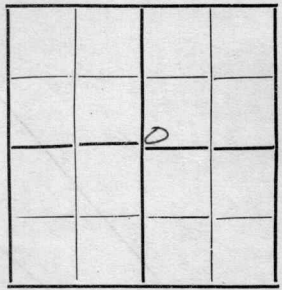

Location.....

Rig up.....

Drilling and Remarks:

RECORD

Cased..... in., ft.

Sand Hunter 3284

Gas.....

Oil.....

Total Depth 3308

PRODUCTION

1st 24 hrs. Nat.....

1st 24 hrs. after shot.....

Gas..... Cu. Ft.

Dry Hole.....

Abandoned.....

pot 1450 natural

Date

MAR 18 1936

ORVAL MANNSCHRECK

Scout