


Section 29 Township 21 Range 1-W

Well Number 4-Hetzke

Company Continental et al

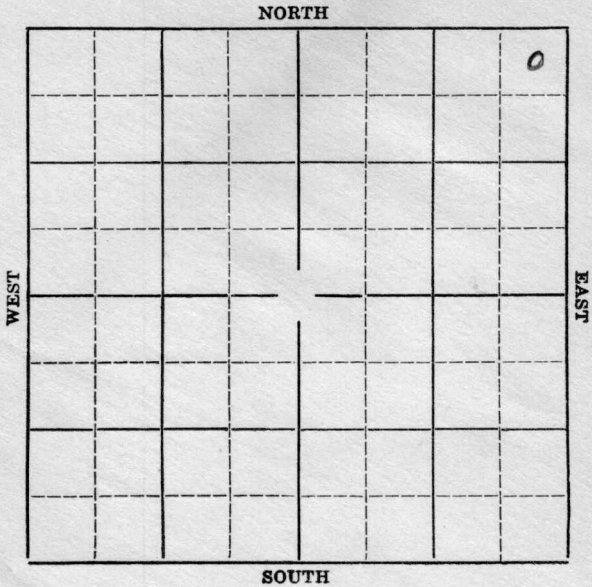

Map No. KANSAS Sec. 29 Twp. 21 R. 1W

Well No. #4 Hetzke Farm

Continental Oil et al Company


330' Ft. from N. Line

_____ Ft. from S. Line

330' Ft. from E. Line

_____ Ft. from W. Line

Elev. 1480

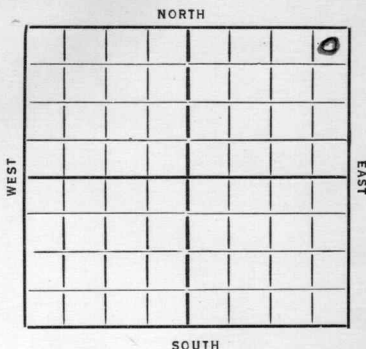

Date	REPORT
1936	Location
6/24	Location
7/2	Cellar.
7/9	Surface hole.
7/16	Drlg. 1965'.
7/23	Drlg. 2840'.
7/30	Hunton 3303'. Set 7". 3307'.
8/6	T.D. 3319'. 2500' of oil.
8/12/36	-Hunton 3303'.
	T.D. 3319'.
	4000 gallons of acid.
	Potential 1360 bbls of oil.
	COMPLETED

Map No. 43 Sec. 29 Twp. 21 R. 11

Well No. 4 Heteke

Continental & Co. Company

Contractor

SECTION PLAT

			0

336 Ft. from N. Line

Ft. from S. Line

330 Ft. from E. Line

Ft. from W. Line

FIRST REPORT

Location ✓

Rig up _____

Drilling and Remarks:

RECORD

Cased _____ in., _____ ft.

Sand _____

Gas _____

Oil _____

Total Depth _____

PRODUCTION

1st 24 hrs. Nat. _____

1st 24 hrs. after shot _____

Gas _____ Cu. Ft.

Dry Hole _____

Abandoned _____

Date

JUN 2 ± 1936

KANSAS

Map No. 43 Sec. 29 Twp. 21 R. 1W

Well No. 4 Hetcher

Continental Company

Contractor

SECTION PLAT

			0

230 Ft. from N. Line

_____ Ft. from S. Line

330 Ft. from E. Line

_____ Ft. from W. Line

COMPLETED

Location _____

Rig up _____

Drilling and Remarks:

Hunter 8303

4000 acid

28/1360

RECORD

Cased _____ in., _____ ft.

Sand _____

Gas _____

Oil _____

Total Depth 3319

PRODUCTION

1st 24 hrs. Nat. _____

1st 24 hrs. after shot _____

Gas _____ Cu. Ft.

Dry Hole _____

Abandoned _____

Date

AUG 12 1936 19

S. J. LEWIS Scout