


Section 29 Township 21 Range 1W

Well Number 5 Hetzke

Company Continental

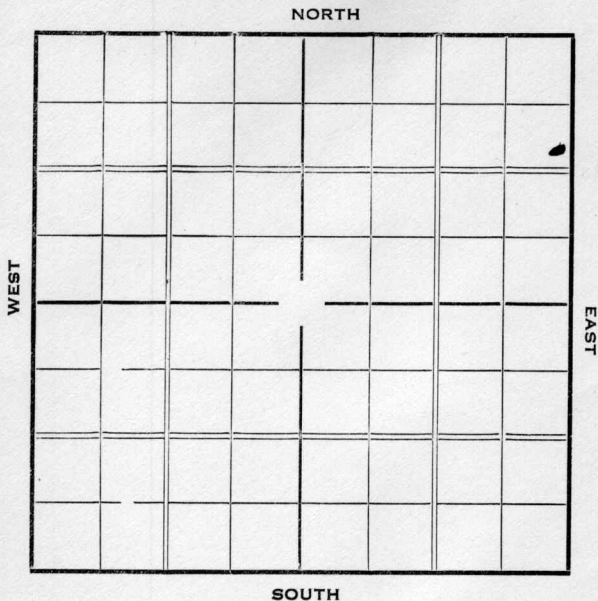

Sec. 29 Twp. 21 R. 1-W


Well No. #5 Hetzke Farm
Continental Company

990 Ft. from N. Line

_____ Ft. from S. Line

330 Ft. from E. Line

_____ Ft. from W. Line

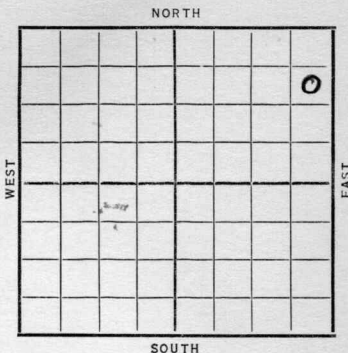

Date	REPORT
1/13	Location
1/21	"
1/28	"
2/4	"
2/11	Cellar
2/18	10" @ 130'. WOC.
2/26	Drlg. 2195'.
3/4	Chat 2930' Drlg. 2952'
3/11	Hunton 3302'. 7" @ 3305' RUST.
3/18	Drlg. 3328-1800' oil in hole
3/25	T.D. 3340'. 2000 acid.
	Pump 443 bbls. 12 hrs.
3/31	Hunton 3302'.
	T.D. 3340'.
	2000 acid.
	Potential 900.
COMPLETED	

KANSAS

Map No. 43 Sec. 29 Twp. 21 R. 1W

Well No. 5 Metzke

Continental Company

Contractor

SECTION PLAT

			0

990 Ft. from N. Line

_____ Ft. from S. Line

330 Ft. from E. Line

_____ Ft. from W. Line

FIRST REPORT

Location

Rig up _____

Drilling and Remarks:

RECORD

Cased _____ in., _____ ft.

Sand _____

Gas _____

Oil _____

Total Depth _____

PRODUCTION

1st 24 hrs. Nat. _____

1st 24 hrs. after shot _____

Gas _____ Cu. Ft.

Dry Hole _____

Abandoned _____

Date

JAN 13 1937 19

S. J. LEWIS

Scout

KANSAS *McPherson*

Map No. _____ Sec. 29 Twp. 21 R. 1W

Well No. 5 Hetzke

Continental Company

Contractor

SECTION PLAT

			0

990 Ft. from N. Line

_____ Ft. from S. Line

330 Ft. from E. Line

_____ Ft. from W. Line

COMPLETED

Location _____

Rig up _____

Drilling and Remarks:

Hutton 3302

2000 acid

Potential

900

RECORD

Cased _____ in., _____ ft.

Sand _____

Gas _____

Oil _____

Total Depth 3340

PRODUCTION

1st 24 hrs. Nat. _____

1st 24 hrs. after shot _____

Gas _____ Cu. Ft.

Dry Hole _____

Abandoned _____

Date

MAR 31 1937

19

S. J. LEWIS Scout