


Section 29 Township 21 Range 1-W

Well Number 6 Hetzke

Company Continental

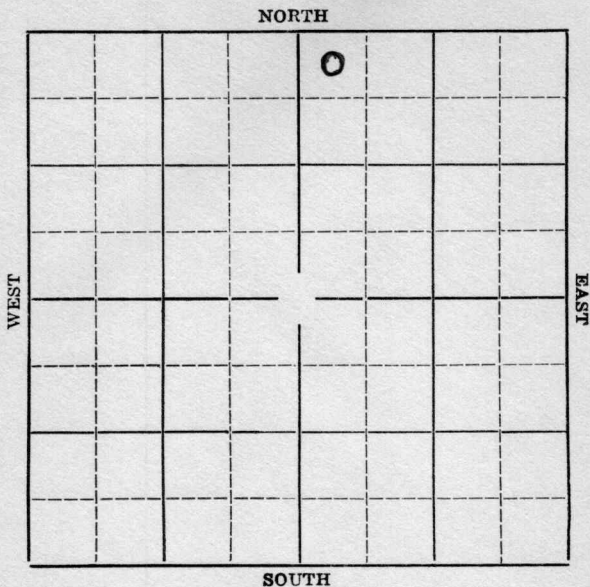

Sec. 29 Twp. 21 R. 1-W


Well No. #6 Hetzke Farm
Continental Company

330 Ft. from N. Line

_____ Ft. from S. Line

_____ Ft. from E. Line

330 Ft. from W. Line

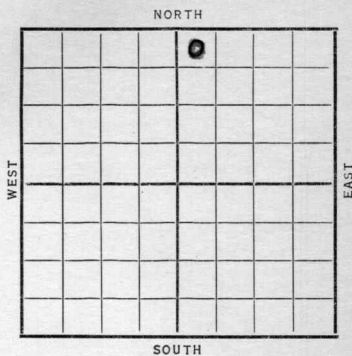

Date 1937

REPORT

2/24 10" @ 140'. WOC.
3/4 Shut Down.

3/11 Chat 2898'. Drlg. 2945'.

3/18 Hunton 3267' - 6" @ 3268' RUST

3/25 T.D. 3316'. 2000' oil in hole.

3/31 Hunton 3267'.

T.D. 3316'.

2000 acid.

Potential 692.

COMPLETED

Map No. 43 Sec. 29 Twp. 21 R. 1W

Well No. 6. H & T p.c.

Continental Company

Contractor

SECTION PLAT

		6	

330 Ft. from N. Line

_____ Ft. from S. Line

_____ Ft. from E. Line

380 Ft. from W. Line

FIRST REPORT

Location _____

Rig up _____

Drilling and Remarks:

16" C 140 WOC

RECORD

Cased _____ in., _____ ft.

Sand _____

Gas _____

Oil _____

Total Depth _____

PRODUCTION

1st 24 hrs. Nat. _____

1st 24 hrs. after shot _____

Gas _____ Cu. Ft.

Dry Hole _____

Abandoned _____

Date

FEB 24 1937 19

S. J. LEWIS

Scout

KANSAS *McPherson*

Map No. 43 Sec. 29 Twp. 21 R. 1W

Well No. 6 H & T 66

Continental Company

Contractor

SECTION PLAT

		0	

330 Ft. from N. Line

 Ft. from S. Line

 Ft. from E. Line

330 Ft. from W. Line

COMPLETED

Location _____

Rig up _____

Drilling and Remarks:

Huntou 8267
2000 acid
Potential
692.

RECORD

Cased _____ in., _____ ft.

Sand _____

Gas _____

Oil _____

Total Depth 3316

PRODUCTION

1st 24 hrs. Nat. _____

1st 24 hrs. after shot _____

Gas _____ Cu. Ft.

Dry Hole _____

Abandoned _____

Date

MAR 31 1937

19

S. J. LEWIS Scout