


Section 29 Township 21 Range 1W

Well No. 9 Hetzke

Company Continental etal

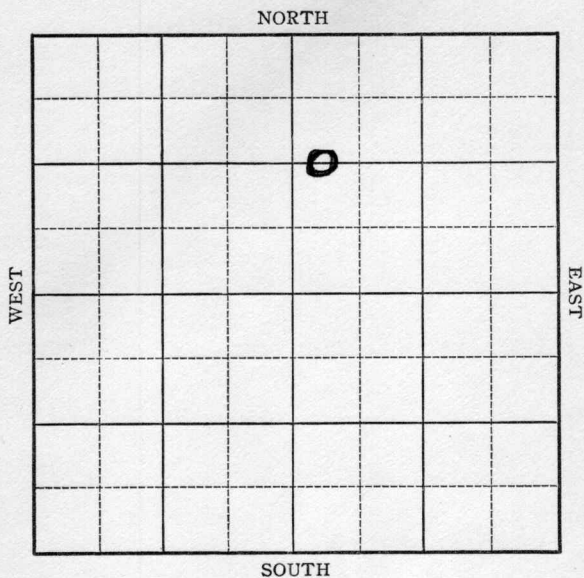

KANSAS *McPherson*

Map No. _____ Sec. 29 Twp. 21 R. 1 ^W

Well No. 9-Hetzke

Continental etal Company

Contractor _____

FIRST REPORT

1320 Ft. from N. Line

_____ Ft. from S. Line

330 Ft. from E. Line

_____ Ft. from W. Line

SECTION PLAT

		○	

Location _____

Rig up _____

Drilling and Remarks:

R.R.

RECORD

Cased _____ in., _____ ft.

Sand _____

Gas _____

Oil _____

Total Depth _____

PRODUCTION

1st 24 hrs. Nat. _____

1st 24 hrs. after shot _____

Gas _____ Cu. Ft.

Dry Hole _____

Abandoned _____

Date

JUL 28 1937

19

H. D. Hatfield Scout

KANSAS

Map No. 43 Sec. 29 Twp. 21 R. 1W

Well No. 9- Hutzka
Continental Steel Company

Contractor

COMPLETED

1320 Ft. from N. Line
_____ Ft. from S. Line
_____ Ft. from E. Line
330 Ft. from W. Line

SECTION PLAT

		0	

Location _____

Rig up _____

Drilling and Remarks:
4000 acid

Prod. 770 bbls

RECORD

Cased 7 in., 3266 ft.
Sand Huntow 3266
Gas _____
Oil _____
Total Depth 3310

PRODUCTION

1st 24 hrs. Nat. _____
1st 24 hrs. after shot _____
Gas _____ Cu. Ft.
Dry Hole _____
Abandoned _____

Date

SEP 8 1937

19

H. D. Hatfield

Scout