


KANSAS

Section 29 Township 21 Range 1W

Well No. #12 Hetzke

Company Continental et al

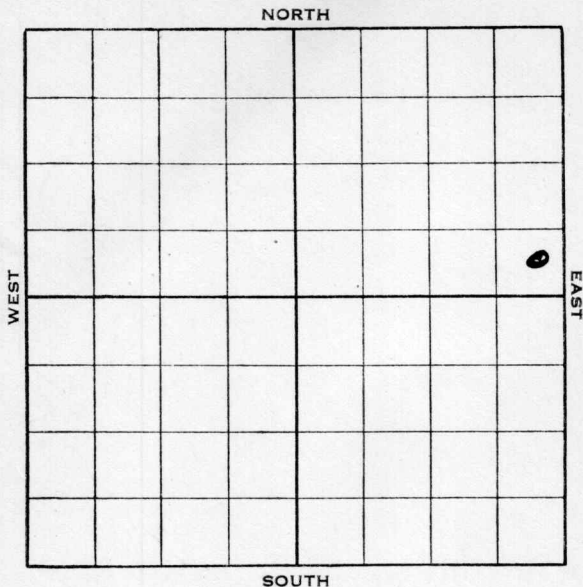

Sec. 29 Twp. 21 R. 1-W


Well No. #12 Hetzke Farm \_\_\_\_\_  
Continental et al Company \_\_\_\_\_

\_\_\_\_\_ Ft. from N. Line

330 Ft. from S. Line

330 Ft. from E. Line

\_\_\_\_\_ Ft. from W. Line

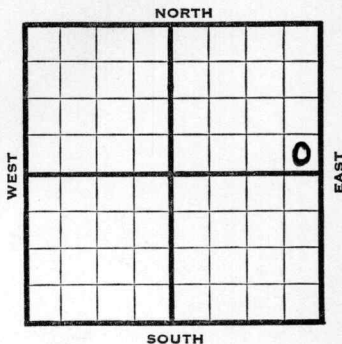

Elev. 1495

1938	REPORT
4/20	B.R.R.
4/29	10" @ 164'. Drlg. 1170'.
5/6	Drlg. 2874'.
5/12	Chat 2933'. Hunton 3312'.
	T.D. 3315'. No shows.
	6" @ 3313'. RUST.
5/20	T.D. 3335'. 1600' oil 4 hrs.
5/25	6" @ 3313'.
	Hunton 3312'.
	T.D. 3335'.
	4000 acid.
	Potential 464 bbls.
	COMPLETED

Map No. 43 Sec. 29 Twp. 21 R. 1W

Well No. 12 Hetzke

Continental etal Company

Contractor

FIRST REPORT

SECTION PLAT

SE NE

\_\_\_\_\_ Ft. from N. Line

330 Ft. from S. Line

330 Ft. from E. Line

\_\_\_\_\_ Ft. from W. Line

			0

Location \_\_\_\_\_

Rig up \_\_\_\_\_

Drilling and Remarks:

BRR

RECORD

Cased \_\_\_\_\_ in., \_\_\_\_\_ ft.

Sand \_\_\_\_\_

Gas \_\_\_\_\_

Oil \_\_\_\_\_

Total Depth \_\_\_\_\_

PRODUCTION

1st 24 hrs. Nat. \_\_\_\_\_

1st 24 hrs. after shot \_\_\_\_\_

Gas \_\_\_\_\_ Cu. Ft.

Dry Hole \_\_\_\_\_

Abandoned \_\_\_\_\_

Date

APR 20 1938 19

H. D. Hatfield Scout

Map No. 43 Sec. 29 Twp. 21 R. 1W

Well No. 12 Hetzke

Continental etal Company

Contractor

**COMPLETED**

**SECTION PLAT**

**SE NE**

\_\_\_\_\_ Ft. from N. Line

330 Ft. from S. Line

330 Ft. from E. Line

\_\_\_\_\_ Ft. from W. Line


Location \_\_\_\_\_

Rig up \_\_\_\_\_

Drilling and Remarks:

*400 acid*

*POT 464*

**RECORD**

Cased 6 in., 333 ft.

Sand HUNTON 3312

Gas \_\_\_\_\_

Oil \_\_\_\_\_

Total Depth 3335

**PRODUCTION**

1st 24 hrs. Nat. \_\_\_\_\_

1st 24 hrs. after shot \_\_\_\_\_

Gas \_\_\_\_\_ Cu. Ft.

Dry Hole \_\_\_\_\_

Abandoned \_\_\_\_\_

Date

MAY 25 1938 19

H. D. Hatfield Scout