


McPherson

KANSAS

Section.....29.....Township.....21.....Range.....1-W.....

Well Number.....3 - Huxman.....

Company.....Continental et al.....

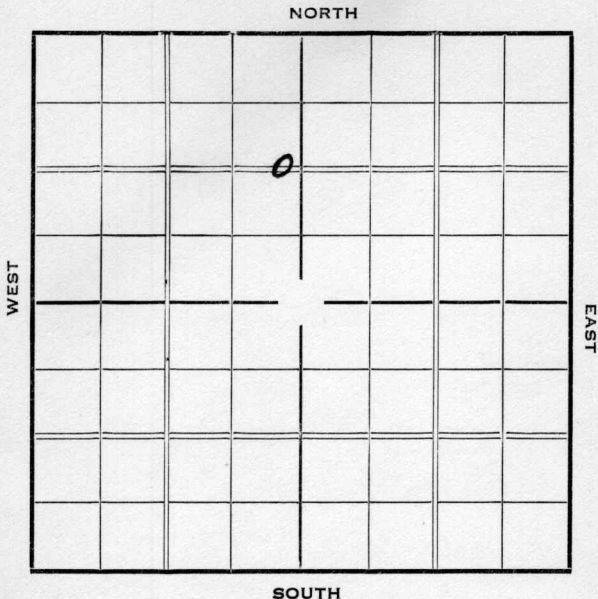

KANSAS *McPherson*

Map No. _____ Sec. 29 Twp. 21 R. 1^w

Well No. 3 - Husman

Continental etal Company

Contractor

FIRST REPORT

SECTION PLAT

1320 Ft. from N. Line
_____ Ft. from S. Line
330 Ft. from E. Line
_____ Ft. from W. Line

	o		

Location _____

Rig up _____

Drilling and Remarks:

S.H.

RECORD

Cased _____ in., _____ ft.
Sand _____
Gas _____
Oil _____
Total Depth _____

PRODUCTION

1st 24 hrs. Nat. _____
1st 24 hrs. after shot _____
Gas _____ Cu. Ft.
Dry Hole _____
Abandoned _____

Date

JUL 14 1937

H. D. Hatfield

Scout

KANSAS

McPherson

Map No. _____ Sec. 29 Twp. 21 R. 1 W

Well No. 3 - Hudson

Continental etal Company

Contractor

COMPLETED

SECTION PLAT

1320 Ft. from N. Line

_____ Ft. from S. Line

330 Ft. from E. Line

_____ Ft. from W. Line

	o		

Location _____

Rig up _____

Drilling and Remarks:

4000 Acid

Pot- 572

RECORD

Cased 7 in., 3251 ft.

Sand Hutton 3248

Gas _____

Oil _____

Total Depth 3275

PRODUCTION

1st 24 hrs. Nat. _____

1st 24 hrs. after shot _____

Gas _____ Cu. Ft.

Dry Hole _____

Abandoned _____

Date

AUG 18 1937 19

H. D. Hatfield Scout