


Section 29 Township 21 Range 1-W

Well No. 4- Huxman

Company Continental et al

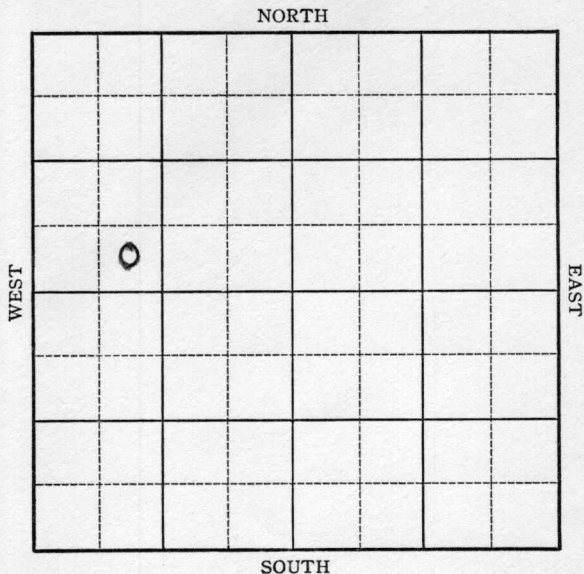

Sec. 29 Twp. 21 R. 1-W

Well No. #4 Huxman Farm

Continental et al Company


_____ Ft. from N. Line

330 Ft. from S. Line

_____ Ft. from E. Line

990 Ft. from W. Line

Elev. 1478

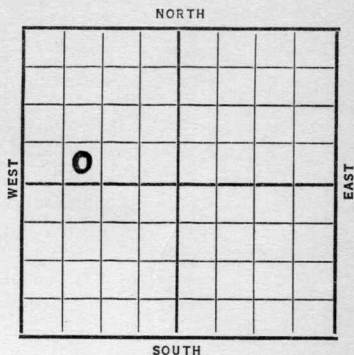

Date	REPORT
1937	
8/18	Cellar
8/28	10" @ 144'. WOC.
9/3	Drlg. 1780'.
9/10	Chat 2890'. Drlg. 2916'.
	No shows.
9/17	Hunton 3258'. 7" @ 3259'.
	T.D. 3262'. No shows Rep.
9/24	T.D. 3279'. 2500' oil.
9/29	7" @ 3259'.
	Hunton 3258'.
	T.D. 3303'.
	4000 acid.
	Pot. 598 bbls.
	COMPLETED

KANSAS *McPherson*

Map No. _____ Sec. *29* Twp. *21* R. *1 W*

Well No. *4 - Gupman*

Continental etal Company

Contractor _____

FIRST REPORT

SECTION PLAT

_____ Ft. from N. Line

330 Ft. from S. Line

_____ Ft. from E. Line

990 Ft. from W. Line

<i>0</i>			

Location _____

Rig up _____

Drilling and Remarks:

Cellar

RECORD

Cased _____ in., _____ ft.

Sand _____

Gas _____

Oil _____

Total Depth _____

PRODUCTION

1st 24 hrs. Nat. _____

1st 24 hrs. after shot _____

Gas : _____ Cu. Ft.

Dry Hole _____

Abandoned _____

Date

AUG 18 1937 19 _____

H. D. Hatfield Scout

