


McPherson

Section 29 Township 21 Range 1-W

Well No. 6 Huxman

Company Continental et al

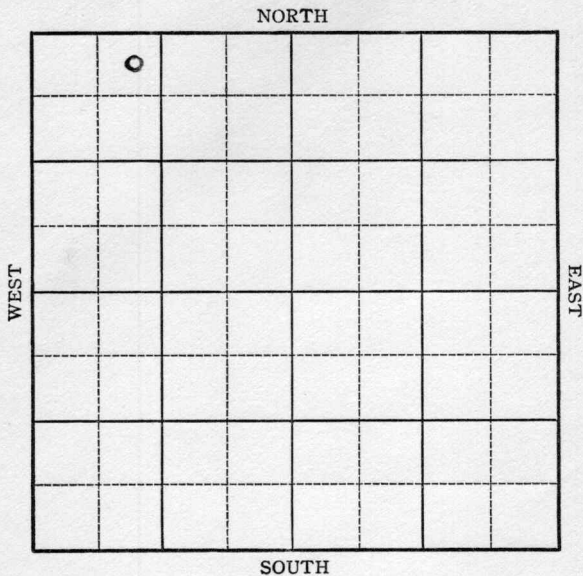

Sec. 29 Twp. 21 R. 1-W

Well No. #6 Huxman Farm _____
Continental et al Company


330 Ft. from N. Line

_____ Ft. from S. Line

_____ Ft. from E. Line

990 Ft. from W. Line

Elev. 1485

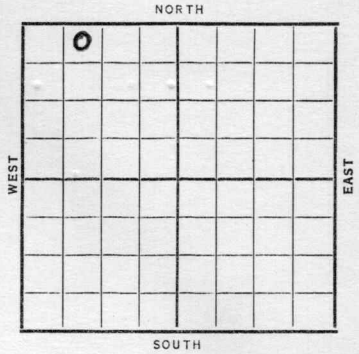

Date	REPORT
1937	
12/22	Cellar.
12/31	R U R
1938	
1/7	10" @ 152'. Drlg. 1225'.
1/14	Chat 2900'. Drlg. 2930'.
	No shows.
1/20	Hunton 3268- 3340' good S.O.
	Viola 3367' S.O. 3369-71'
	Wilcox 3398-3406' T.D. S.O.
	7" - 3389' R.U.S.T.
1/28	Drlg. plug
2/4	Wilcox 3398'
	At 3406' had 2800' oil in hole
	Swb 160 bbls oil in 5 hrs.
	At 3413' had 3000' oil &
	Swb 308 oil in 8 hrs.
	T.D. 3418' had S.W.
	Will plug off Wilcox oil. Grav. 32.
	OVER

1938

2/11 P.B. 3343'.
Perforated 160 shots 3268-3300'.
700' oil. 4000 acid.

2/16 7" @ 3389'.
Hunton 3268'.
Viola 3367'.
Wilcox 3398'.
Wilcox Pay plugged off.
T.D. 3418'.
P.B. 3343'.
Perf. 160 shots @ 3268-3300'.
4000 acid.
Potential 582 bbls.

COMPLETED

Map No. 43 Sec. 29 Twp. 21 R. 1W

Well No. 6 Huxman

Continental etal Company

Contractor

FIRST REPORT

NE NW NW

330 Ft. from N. Line

_____ Ft. from S. Line

_____ Ft. from E. Line

990 Ft. from W. Line

SECTION PLAT

0			

Location _____

Rig up _____

Drilling and Remarks:

Cellar

RECORD

Cased _____ in., _____ ft.

Sand _____

Gas _____

Oil _____

Total Depth _____

PRODUCTION

1st 24 hrs. Nat. _____

1st 24 hrs. after shot _____

Gas _____ Cu. Ft.

Dry Hole _____

Abandoned _____

Date

DEC 22 1937

H. D. Hatfield

19

Scout

Map No. _____ Sec. 29 Twp. 21 R. 1W

Well No. 6 Huxman

Continental etal Company

Contractor

COMPLETED

NE NW NW

330 Ft. from N. Line

_____ Ft. from S. Line

_____ Ft. from E. Line

990 Ft. from W. Line

SECTION PLAT

0			

Location _____

Rig up _____

Drilling and Remarks:

Wilcox Pay Plugged off

P.B. 3343

RECORD

Cased 7 in. 3389 ft.

Sand Hutton 3268

Gas Viola 5367

Oil Wilcox 3398

Total Depth 3418

PRODUCTION

1st 24 hrs. Nat. _____

1st 24 hrs. after shot _____

Gas _____ Cu. Ft.

Dry Hole _____

Abandoned _____

Date

FEB 16 1938 19

H. D. Hatfield

Scout

*Perf. 160 shots @
3268-3300
4000 acid
POT 582*