


McPherson

Section 29 Township 21 Range 1-W

Well No. 7 Huxman

Company Continental et al

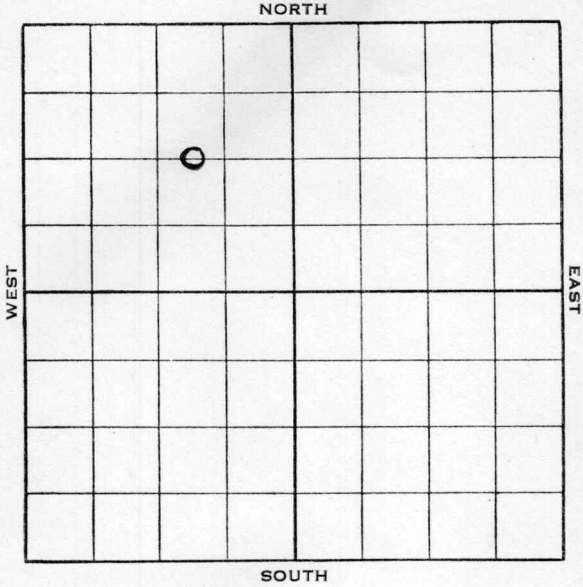

Sec. 29 Twp. 21 R. 1-W

Well No. #7 Huxman Farm
Continental et al Company


1320 Ft. from N. Line

_____ Ft. from S. Line

990 Ft. from E. Line

_____ Ft. from W. Line

Elev. 1481'

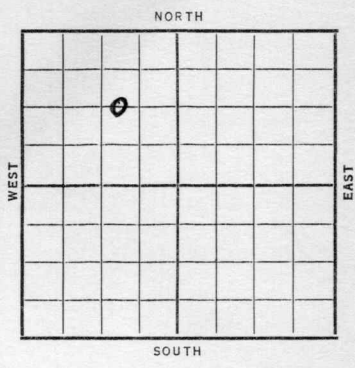

Date	REPORT
1938	
2/2	Location
2/11	B.R.R.
2/18	10" @ 149'. Drlg. 550'.
2/26	Drlg. 2675'.
3/4	Hunton 3268'. 7" @ 3269'.
	T.D. 3270'. RUST.
3/11	T.D. 3291'. 1800' oil.
	4000 acid.
3/16	7" @ 3269'.
	Hunton 3268'.
	T.D. 3291'.
	4000 acid.
	Potential 452 bbls.
	COMPLETED

Map No. 43 Sec. 29 Twp. 21 R. 1W

Well No. 7 Huxman

Continental etal Company

Contractor

FIRST REPORT

SECTION PLAT

C W L E $\frac{1}{2}$ NW

1320 Ft. from N. Line

_____ Ft. from S. Line

990 Ft. from E. Line

_____ Ft. from W. Line

	o		

Location X

Rig up _____

Drilling and Remarks:

RECORD

Cased _____ in., _____ ft.

Sand _____

Gas _____

Oil _____

Total Depth _____

PRODUCTION

1st 24 hrs. Nat. _____

1st 24 hrs. after shot _____

Gas _____ Cu. Ft.

Dry Hole _____

Abandoned _____

Date

FEB 2 1938 19

H. D. Hatfield Scout

Map No. 43 Sec. 29 Twp. 21 R. 1W

Well No. 7 Huxman

Continental etal Company

Contractor

COMPLETE

SECTION PLAT

1320 **C W L E $\frac{1}{2}$ NW** Ft. from N. Line
 _____ Ft. from S. Line
990 Ft. from E. Line
 _____ Ft. from W. Line

	0		

Location _____

Rig up _____

Drilling and Remarks:

4000 Acid

Pot 452

RECORD

Cased 7 in. 3269 ft.

Sand Hutton 3268

Gas _____

Oil _____

Total Depth 3291

PRODUCTION

1st 24 hrs. Nat. _____

1st 24 hrs. after shot _____

Gas _____ Cu. Ft.

Dry Hole _____

Abandoned _____

Date

MAR 16 1938