


McPherson

Section 29 Township 21 Range 1-W

Well No. #8 Huxman

Company Continental et al

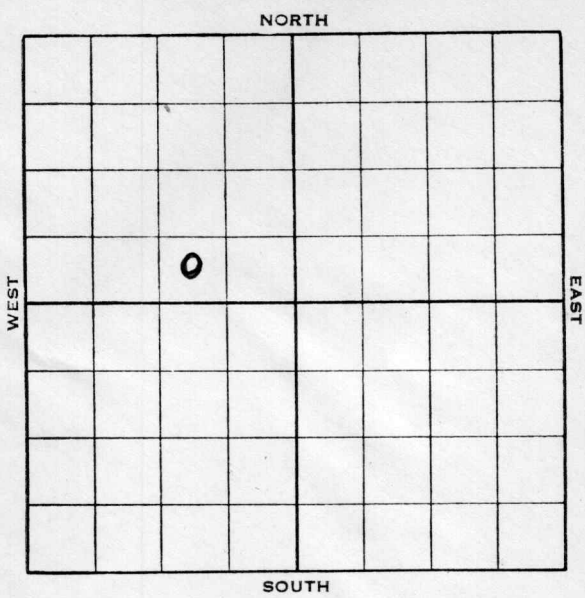

Sec. 29 Twp. 21 R. 1-W

Well No. #8 Huxman Farm

Continental et al Company


_____ Ft. from N. Line

330 Ft. from S. Line

990 Ft. from E. Line

_____ Ft. from W. Line

Elev. 1470

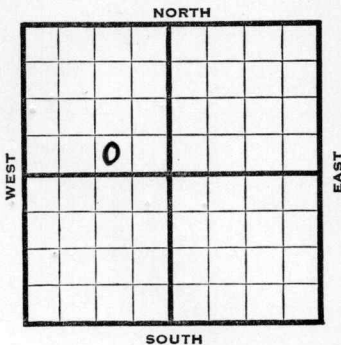

1938	REPORT
5/10	Location
5/20	"
5//27	"
6/3	R. R.
6/10	"
6/17	"
6/24	10" - 147'.
7/1	T.D. 1697' Fsg.
7/8	Drlg. 2618'.
7/15	Chat 2890'. Hunton 3251'.
	T. D. 3253'. No shows rept.
	7" - 3252'. RUST.
7/22	T.D. 3290'. 2000' oil.
	OVER

1938

7/27

7" - 3252' . .

Hunton 3251' .

T. D. 3290' .

2000 acid.

Potential 568 bbls.

COMPLETED

Map No. 43 Sec. 29 Twp. 21 R. 1W

Well No. 8 Huxman

Continental etal Company

Contractor

FIRST REPORT

SW SE NW

_____ Ft. from N. Line

330 Ft. from S. Line

990 Ft. from E. Line

_____ Ft. from W. Line

SECTION PLAT

	0		

Location X

Rig up _____

Drilling and Remarks:

RECORD

Cased _____ in., _____ ft.

Sand _____

Gas _____

Oil _____

Total Depth _____

PRODUCTION

1st 24 hrs. Nat. _____

1st 24 hrs. after shot _____

Gas _____ Cu. Ft.

Dry Hole _____

Abandoned _____

Date

MAY 10 1938 19 H. D. Hatfield Scout

Map No. 43 Sec. 29 Twp. 21 R. 1W

Well No. 8 Huxman

Continental etal

Company

Contractor

COMPLETED

SW SE NW

Ft. from N. Line

330 Ft. from S. Line

990 Ft. from E. Line

Ft. from W. Line

SECTION PLAT

Location _____

Rig up _____

Drilling and Remarks:

*2000 acid
Pot 568*

RECORD

Cased 7 in. 3252 ft.

Sand HUNTON 3251

Gas _____

Oil _____

Total Depth 3290

PRODUCTION

1st 24 hrs. Nat. _____

1st 24 hrs. after shot _____

Gas _____ Cu. Ft.

Dry Hole _____

Abandoned _____

Date

JUL 27 1938

19

H. D. Hatfield Scout