

# KANSAS


Form 51-5M-7-39-Palace

McPherson

Section 29 Township 21 Range 1-W

Well No. 9 Huxman

Company Continental et al

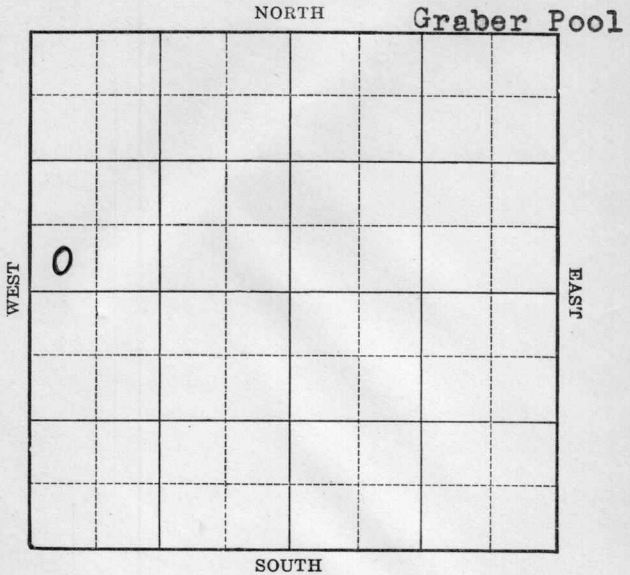

Sec. 29 Twp. 21 R. 1-W

Well No. #9 Huxman Farm

Continental et al Company


(Graber)

\_\_\_\_\_ Ft. from N. Line

330 Ft. from S. Line

\_\_\_\_\_ Ft. from E. Line

330 Ft. from W. Line

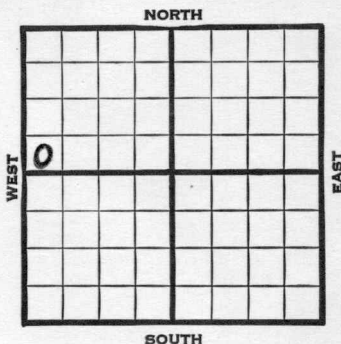

1939	REPORT
9/6	Derrick.
9/14	10" - 149' Drlg. 2155'
9/21	Drlg. 2810'
9/28	Hunton 3240' 6" - 3242'
	T.D. 3254' RUST.
10/5	T.D. 3280' 1150' oil.
	4000 acid.
10/11	Hunton 3240'
	6" - 3242'
	T.D. 3280'
	4000 acid.
	Pump 427 bbls.
	COMPLETED

Map No. 43 Sec. 29 Twp. 21 R. 1W

Well No. 9 Huxman

Continental etal Company

Contractor

FIRST REPORT

SW NW

SECTION PLAT


         Ft. from N. Line

330 Ft. from S. Line

         Ft. from E. Line

330 Ft. from W. Line

GRABER POOL

Location                                 

Rig up                                 

Drilling and Remarks:

Derrick

RECORD

Cased          in.,          ft.

Sand                                 

Gas                                 

Oil                                 

Total Depth                         

PRODUCTION

1st 24 hrs. Nat.                         

1st 24 hrs. after shot                         

Gas                                  Cu. Ft.

Dry Hole                                 

Abandoned                                 

Date

SEP 6 1939 19

S. J. LEWIS Scout

Map No. 43 Sec. 29 Twp. 21 R. 1W

Well No. 9 Huxman

**Continental etal** Company

Contractor

**COMPLETED**

**SECTION PLAT**

**SW NW**

\_\_\_\_\_ Ft. from N. Line

**330** Ft. from S. Line

\_\_\_\_\_ Ft. from E. Line

**330** Ft. from W. Line


**GRABER POOL**

Location \_\_\_\_\_

Rig up \_\_\_\_\_

Drilling and Remarks:

*Hutton 3240*

*6" @ 3242*

*4000 acid*

*Pump 427*

**RECORD**

Cased \_\_\_\_\_ in., \_\_\_\_\_ ft.

Sand \_\_\_\_\_

Gas \_\_\_\_\_

Oil \_\_\_\_\_

Total Depth 3280

**PRODUCTION**

1st 24 hrs. Nat. \_\_\_\_\_

1st 24 hrs. after shot \_\_\_\_\_

Gas \_\_\_\_\_ Cu. Ft.

Dry Hole \_\_\_\_\_

Abandoned \_\_\_\_\_

Date

**OCT 11 1939** 19

**S. J. LEWIS** Scout