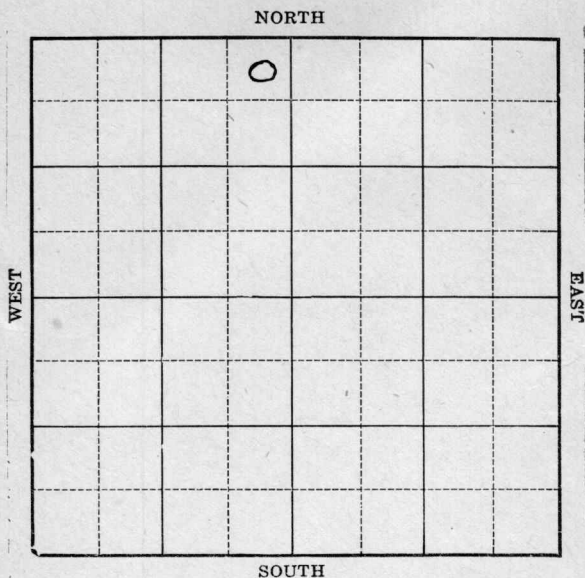


Form 51—5M—11-31—Palace

Map No. _____ Sec. 32 Twp. 21 R. 1WWell No. 1 Greber Farm _____Continental Oil Company _____

Location _____

Drilling Remarks _____

Rig Up _____

Drilling Remarks _____

RECORD

Cased _____ in. _____ ft.

Sand _____

Gas _____

Oil _____

Total Depth _____

PRODUCTION

1st 24 hrs. Nat. _____

1st 24 hrs. after shot _____

Gas _____ cu. ft.

Dry Hole _____

Abandoned _____

Mc Pherson

Map No. KANSAS Sec. 32 Twp 21 R. 1W

Well No. 1 Gruber Farm


Continental Oil Company

330 Ft. from N. Line

 Ft. from S. Line

330 Ft. from E. Line

 Ft. from W. Line

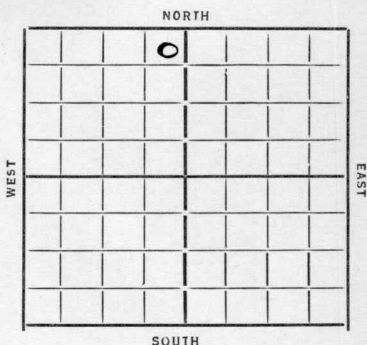

Date
1934

REPORT

3/9 Location
3/15 — 3/22 —
3/29 Rig
4/5 dely 205
4/12 " 960
4/19 " 1585 13" 1500
4/26 " 1950
5/3 K.C. 2285 10" 2310
2474 2405-20 dely 2500
5/10 dely 2550 u.R. 10" 2431
5/18 Chat 2889 2906 8" 2926
2960 TD 3 m hcr.
5/28 Top Hunton 3281
TD 3292 1800 feet oil (Telegram)
5/25 (Chat Corrected 2906
3060 HFW)
5/31 Chat 2906 2474 3060 SD
6/7 Hunton 3281 TD 3292 1/2
swab 435 24 hrs dely 3295
6/14 TD 3298 swab 367 bbls
24 hrs.
6/27 Hunton 3281 TD 3298 870 bbls.

COMPLETED

Map No. 43 Sec. 32 Twp. 21 R. 1W

Well No. 1-Graber

Continental oil Company

Contractor

FIRST REPORTS

330 Ft. from N. Line

..... Ft. from S. Line

330 Ft. from E. Line

..... Ft. from W. Line

SECTION PLAT

	0		

Location ✓

Rig up

Drilling and Remarks:

RECORD

Cased.....in.,ft.

Sand

Gas

Oil

Total Depth

PRODUCTION

1st 24 hrs. Nat.

1st 24 hrs. after shot

Gas.....Cu. Ft.

Dry Hole

Abandoned

Date

3-7-34 192 O. Mammuch Scout

KANSAS

Map No. 43 Sec. 32 Twp. 21 R. 1W

Well No. 1-Graber

Continental Oil Company

Contractor

COMPLETED

SECTION PLAT

	0		

330 Ft. from N. Line

_____ Ft. from S. Line

330 Ft. from E. Line

_____ Ft. from W. Line

Location _____

Rig up _____

Drilling and Remarks:

870 bbls

RECORD

Cased _____ in., _____ ft.

Sand Hurton 3281

Gas _____

Oil _____

Total Depth 3298

PRODUCTION

1st 24 hrs. Nat. _____

1st 24 hrs. after shot _____

Gas _____ Cu. Ft.

Dry Hole _____

Abandoned _____

Date

6-27-34 19

ORVAL MANNSCHRECK

Scout