

KANSAS


McPherson

Form 51—5M—11-38—Palace

Section 32 Township 21 Range 1-W

Well No. #8 Graber

Company Continental et al

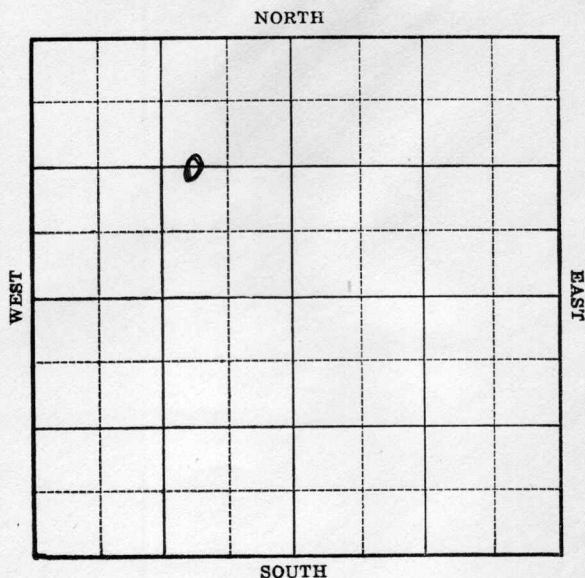


KANSAS

McPherson

Sec. 32 Twp. 21 R. 1-WWell No. #8 Graber FarmContinental et al Company1320 Ft. from N. Line Ft. from S. Line990 Ft. from E. Line Ft. from W. Line

Elev. 1474

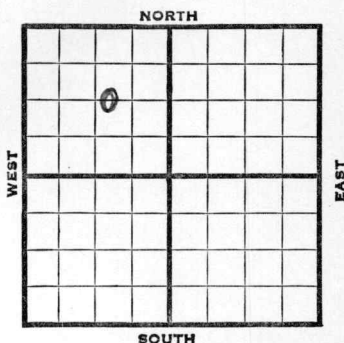

1938	REPORT
12/7	Location
12/15	"
12/23	Mat'l.
12/30	10" - 158'. Drlg. 820'.
1939	
1/6	Chat. 2908'. Drlg. 2918'.
1/13	Hunton 3275'. S. O. 3277-79'.
	T. D. 3282'. 6" - 3276'. RUST.
1/20	T. D. 3306'. 1600' oil.
	Will treat.
1/25	6" - 3276'.
	Hunton 3275'.
	T. D. 3306'.
	4000 acid.
	Pump 146 bbls. 8 hours.
	Potential 437 bbls.
	COMPLETED

Map No. 43 Sec. 32 Twp. 21 R. 1WWell No. 8 GraberContinental etal CompanyContractor

FIRST REPORT

C W L E $\frac{1}{2}$ NW1320 Ft. from N. Line Ft. from S. Line990 Ft. from E. Line Ft. from W. Line

SECTION PLAT

	0		

Location XRig up

Drilling and Remarks:

RECORD

Cased in., ft.Sand Gas Oil Total Depth

PRODUCTION

1st 24 hrs. Nat. 1st 24 hrs. after shot Gas Cu. Ft.Dry Hole Abandoned

Date

DEC 7 - 1938 19H. D. Hatfield Scout

McPherson

KANSAS

Map No. 43 Sec. 32 Twp. 21 R. 1WWell No. 8 GraberContinental etal

Company

Contractor

COMPLETED

C W L E $\frac{1}{2}$ NW1320 Ft. from N. Line Ft. from S. Line990 Ft. from E. Line Ft. from W. Line

GRABER POOL

SECTION PLAT

	0		

Location Rig up

Drilling and Remarks:

4000 acidP-146/8POT 437

RECORD

Cased 6 in., 3276 ft.Sand HUNTON 3275Gas Oil Total Depth 3306

PRODUCTION

1st 24 hrs. Nat. 1st 24 hrs. after shot Gas Cu. Ft.Dry Hole Abandoned

Date

JAN 26 1939 19H. D. Hatfield Scout