



KANSAS

Section 32 Township 21 Range 1-W

Well No. #11 Graber

Company Continental etal
(Graber)

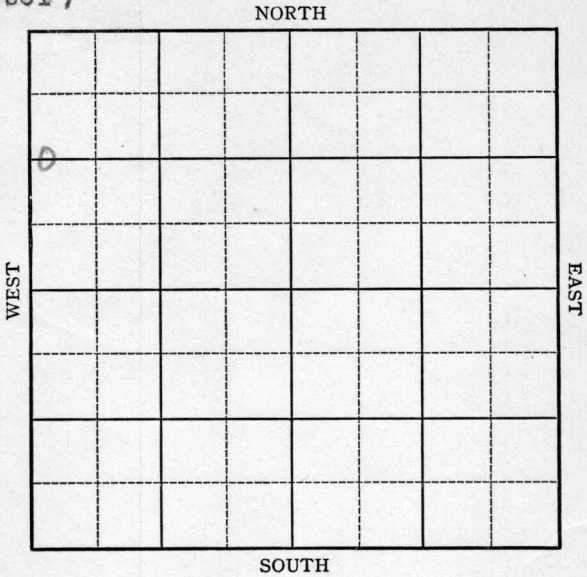

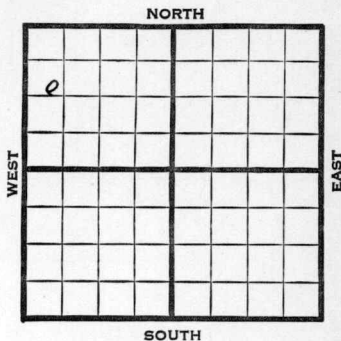[illegible]

Map No. 43 Sec. 32 Twp. 21 R. 1W

Well No. 11 Graber

Continental etal Company

FIRST REPORT Contractor

C W L N W

1280 Ft. from N. Line

_____ Ft. from S. Line

_____ Ft. from E. Line

440 Ft. from W. Line

GRABER POOL

SECTION PLAT

0			

Location _____

Rig up _____

Drilling and Remarks:

10" - 156

Drilg. 2128

RECORD

Cased _____ in., _____ ft.

Sand _____

Gas _____

Oil _____

Total Depth _____

PRODUCTION

1st 24 hrs. Nat. _____

1st 24 hrs. after shot _____

Gas _____ Cu. Ft.

Dry Hole _____

Abandoned _____

Date

AUG 6 1941

19

S. J. LEWIS Scout

Map No. 43 Sec. 32 Twp. 21 R. 1WWell No. 11 GraberContinental etal Company

Contractor

COMPLETED

C W L NW

1280 Ft. from N. Line Ft. from S. Line Ft. from E. Line440 Ft. from W. Line

SECTION PLAT

GRABER POOL

Location Rig up

Drilling and Remarks:

*Acid 3260**5" @ 3262**4000 acid**Pump 243 P.D.**37° Gr*

RECORD

Cased in., ft.Sand Gas Oil Total Depth 3295

PRODUCTION

1st 24 hrs. Nat. 1st 24 hrs. after shot Gas Cu. Ft.Dry Hole Abandoned

Date

AUG 27 1941

19

S. J. LEWIS

Scout