

KANSAS

McPherson

Form 51—5M—7-39—Palace

Section 32 Township 21 Range 1-W

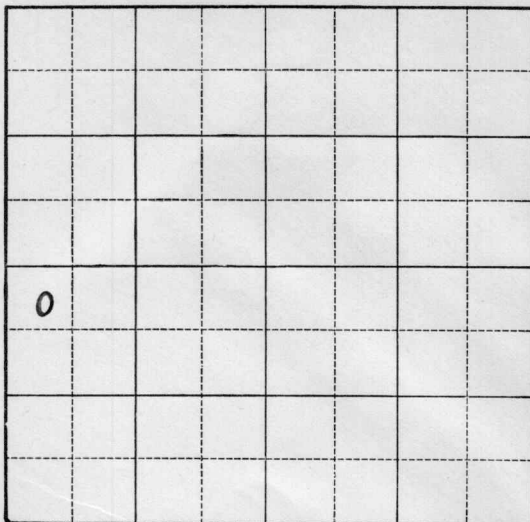
Well No. #1 Jones "B"

Company L. W. Prunty et al

NORTH

Garber Pool

WEST



EAST

SOUTH

Sec. 32 Twp. 21 R. 1-W

Well No. #1 Jones "B" Farm

L. W. Prunty et al _____ Company

(Graber)

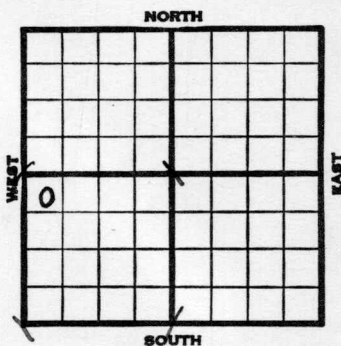
440 Ft. from N. Line

Ft. from S. Line

_Ft. from E. Line

440 Ft. from W. Line

Elev. 1465

[illegible]

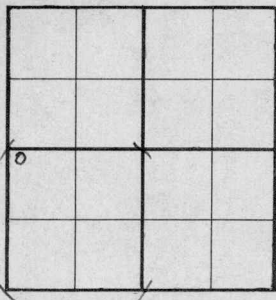
Map No. 43 Sec. 32 Twp. 21 R. 1WWell No. 1 Jones "B"L. W. Prunty et al Company

Contractor

FIRST REPORT

NW SW

SECTION PLAT

440 Ft. from N. Line

_____ Ft. from S. Line

_____ Ft. from E. Line

440 Ft. from W. Line

GRABER POOL

Location _____

Rig up _____

Drilling and Remarks:

13" - 152

WOC

(Less 10 A.
NE/Cor. SW $\frac{1}{4}$)

RECORD

Cased _____ in., _____ ft.

Sand _____

Gas _____

Oil _____

Total Depth _____

PRODUCTION

1st 24 hrs. Nat. _____

1st 24 hrs. after shot _____

Gas _____ Cu. Ft.

Dry Hole _____

Abandoned _____

Date

JAN 3 1940

19

S. J. LEWIS

Scout

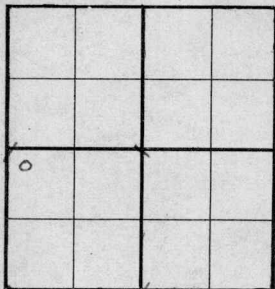
Map No. 43 Sec. 32 Twp. 21 R. 1WWell No. 1 Jones "B"L. W. Prunty etal CompanyCOMPLETED

Contractor

NW SW

SECTION PLAT440 Ft. from N. Line Ft. from S. Line Ft. from E. Line440 Ft. from W. Line

GRABER POOL

Location Rig up

Drilling and Remarks:

*Hunter 3277**4" @ 3280**6000 acid**Pump 714 Pst.***RECORD**Cased in., ft.Sand Gas Oil Total Depth 3295.**PRODUCTION**1st 24 hrs. Nat. 1st 24 hrs. after shot Gas Cu. Ft.Dry Hole Abandoned

Date

JAN 31 1940 19S. J. LEWIS Scout