

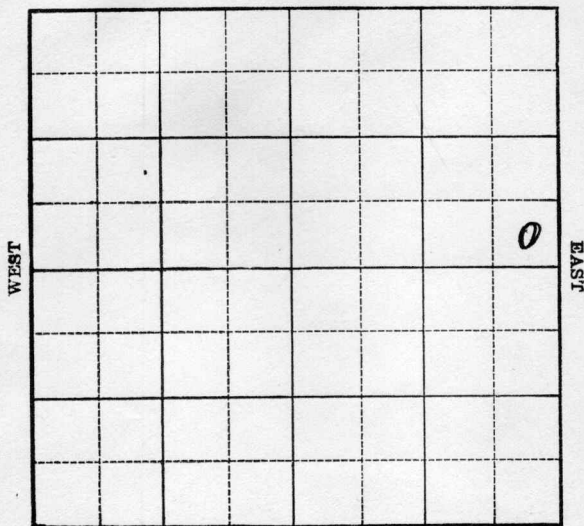
Section 30 Township 21 Range 1-W

Well No. #1 Heintzleman

Company McBride

Graber Pool

NORTH



SOUTH

McPherson

KANSAS

Map No. 43 Sec. 30 Twp. 21 R. 1WWell No. 1 HeintzlemanMcBride

Company

Contractor

FIRST REPORT
SE NE

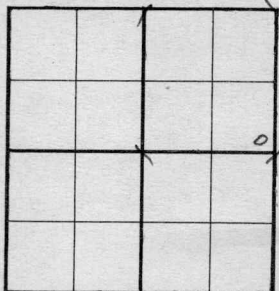
Ft. from N. Line

330 Ft. from S. Line330 Ft. from E. Line

Ft. from W. Line

GRABER POOL

SECTION PLAT

Location X

Rig up

Drilling and Remarks:

Rotary

RECORD

Cased _____ in., _____ ft.

Sand _____

Gas _____

Oil _____

Total Depth _____

PRODUCTION

1st 24 hrs. Nat. _____

1st 24 hrs. after shot _____

Gas _____ Cu. Ft.

Dry Hole _____

Abandoned _____

Date

JUN 28 1939

19

S. J. LEWIS

Scout

Map No. 43 Sec. 30 Twp. 21 R. 1WWell No. 1 HeintzlemanMcBride

Company

Contractor

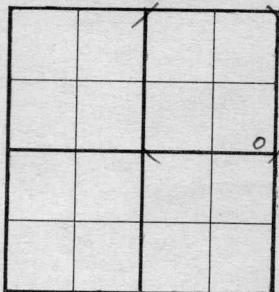
COMPLETED

SE NE

 Ft. from N. Line330 Ft. from S. Line330 Ft. from E. Line Ft. from W. Line

GRABER POOL

SECTION PLAT

Location Rig up

Drilling and Remarks:

*Hutton 3293**7" @ 3298**P. B 3319**3000 cu ft**Pump 239 P. X.*

RECORD

Cased in., ft.Sand Gas Oil Total Depth 3326 1/2

PRODUCTION

1st 24 hrs. Nat. 1st 24 hrs. after shot Gas Cu. Ft.Dry Hole Abandoned

Date

AUG 2 1939 19

S. J. LEWIS Scout