


McPherson KANSAS

Section.....32.....Township.....21.....Range.....1-W.....

Well Number.....5 C.C.Graber.....

Company.....Continental.....

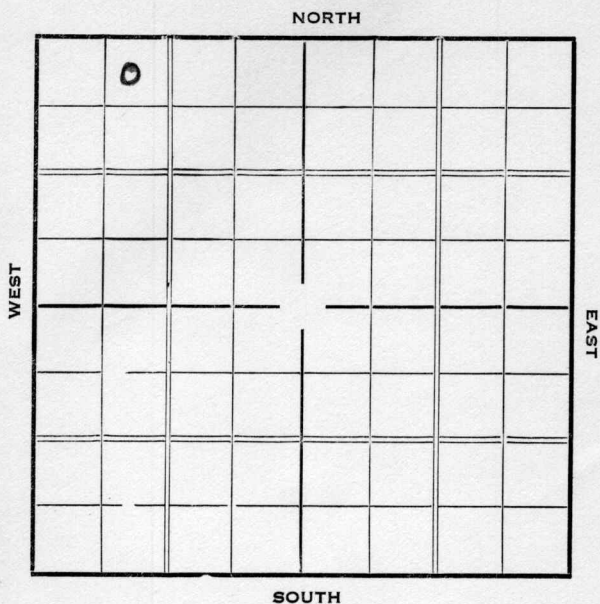

KANSAS

McPherson

Map No. _____ Sec. 32 Twp. 21 R. 1-W

Well No. #5 C. C. Graber Farm


Continental Company

330 Ft. from N. Line

Ft. from S. Line

Ft. from E. Line

975 Ft. from W. Line

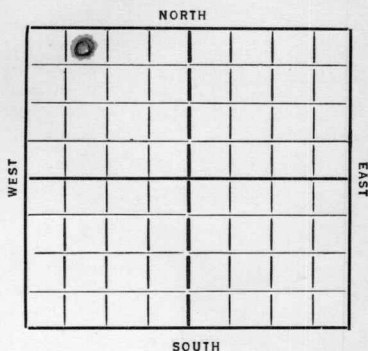

Date
1936

REPORT

12/16 Location

12/24 Rigging up

12/29 12" @ 149'. Drlg. 1825'.

1937

1/7 Chat 2900'. Drlg. 3087'.

1/14 Coring 3253'.

1/21 Hunton 3261'. 7" @ 3263'.

T. D. 3268'. RUST.

1/28 T. D. 3286'.

Swabb 90 bbls. in 5 hrs.

2/3 Hunton 3261'.

T. D. 3286'.

4000 acid.

Pump 856 bbls.

COMPLETED

KANSAS

Map No. 43 Sec. 32 Twp. 21 R. 1W.Well No. 5 C C GraterContinental Company

Contractor

SECTION PLAT

0			

830 Ft. from N. Line

_____ Ft. from S. Line

_____ Ft. from E. Line

915 Ft. from W. Line

FIRST REPORT

Location ✓

Rig up _____

Drilling and Remarks:

RECORD

Cased _____ in., _____ ft.

Sand _____

Gas _____

Oil _____

Total Depth _____

PRODUCTION

1st 24 hrs. Nat. _____

1st 24 hrs. after shot _____

Gas _____ Cu. Ft.

Dry Hole _____

Abandoned _____

Date

DEC 16 1936

19

S. J. LEWIS

Scout

M. Nelson KANSAS

Map No. 43 Sec. 32 Twp. 21 R. 1WWell No. 5 C C GraherContinental Company

Contractor

SECTION PLAT

0			

330 Ft. from N. Line

_____ Ft. from S. Line

_____ Ft. from E. Line

915 Ft. from W. Line

COMPLETED

Location _____

Rig up _____

Drilling and Remarks:

Hutton 32614000 acidPump. 856.88

RECORD

Cased _____ in., _____ ft.

Sand _____

Gas _____

Oil _____

Total Depth 3286

PRODUCTION

1st 24 hrs. Nat. _____

1st 24 hrs. after shot _____

Gas _____ Cu. Ft.

Dry Hole _____

Abandoned _____

Date

FEB 3 1937 19

S. J. LEWIS

Scout