


Section 32 Township 21 Range 1-W


Well Number #3 Wenger

Company Continental et al

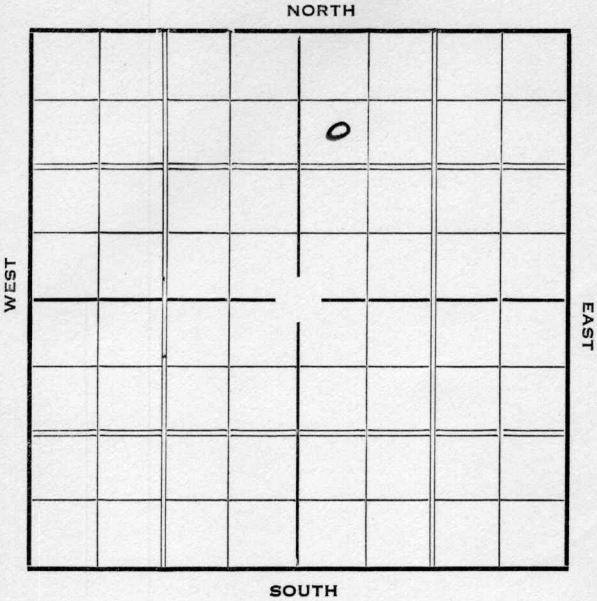

Sec. 32 Twp. 21 R. 1-WWell No. #3 Wenger FarmContinental etal Company990 Ft. from N. Line Ft. from S. Line Ft. from E. Line330 Ft. from W. Line

Elev. 1483

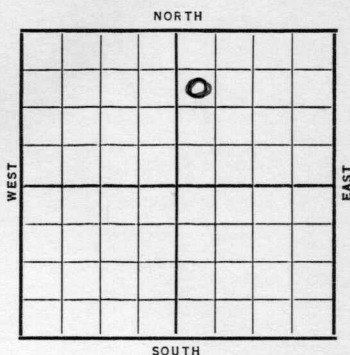

Date

REPORT

1937

10/13 Location

10/22 12" @ 156'. Drlg. 550'.

10/29 Drlg. 2550'.

11/5 Chat 2918'. Drlg. 3285'.

No shows.

11/12 Hunton 3304'. 7" @ 3305'.

T.D. 3306'. No shows. C.O.

11/17 7" @ 3305'.

Hunton 3304'.

T.D. 3333'.

4000 acid.

Potential 569 bbls.

COMPLETED

McPherson KANSAS

Map No. 43 Sec. 32 Twp. 21 R. 1WWell No. 3 WengerContinental etal Company

Contractor

FIRST REPORT

SW NW NE

990 Ft. from N. Line Ft. from S. Line Ft. from E. Line330 Ft. from W. Line

SECTION PLAT

		0	

Location XRig up

Drilling and Remarks:

RECORD

Cased in., ft.Sand Gas Oil Total Depth

PRODUCTION

1st 24 hrs. Nat. 1st 24 hrs. after shot Gas Cu. Ft.Dry Hole Abandoned

Date

OCT 13 1937 19H. D. Hatfield Scout

Map No. _____ Sec. 32 Twp. 21 R. 1WWell No. 3 WengerContinental etal Company

Contractor _____

COMPLETED

SW NW NE

990 Ft. from N. Line

_____ Ft. from S. Line

_____ Ft. from E. Line

330 Ft. from W. Line

SECTION PLAT

		0	

Location _____

Rig up _____

Drilling and Remarks:

4000 acidPOT-569

RECORD

Cased 7 in., 3305 ft.Sand Hunter 3304

Gas _____

Oil _____

Total Depth 3333

PRODUCTION

1st 24 hrs. Nat. _____

1st 24 hrs. after shot _____

Gas _____ Cu. Ft.

Dry Hole _____

Abandoned _____

Date

NOV 17 1937 19 H. D. Hatfield Scout