


M^cPherson

Form 51-5M-2-29-34703

Map No. **KANSAS** Sec. 30 Twp. 19 R. 1^W

Well No. 1-Anderson Farm
Abilene Oil & Shell Company

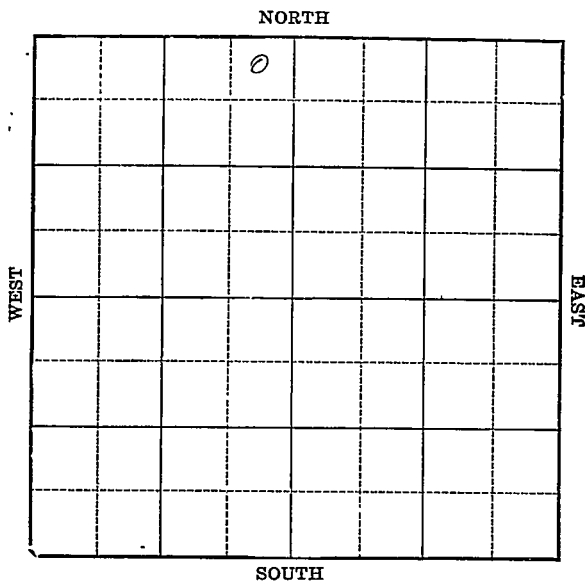

Location _____

Drilling Remarks _____

RECORD

Cased _____ in. _____ ft.

Sand _____

Gas _____

Oil _____

Total Depth _____

Rig Up _____

Drilling Remarks _____

PRODUCTION

1st 24 hrs. Nat. _____

1st 24 hrs. after shot _____

Gas _____ cu. ft.


Dry Hole _____

Abandoned _____

Map No. KANSAS Sec. 30 Twp. 19 R. 1^w

Well No. 1-Anderson Farm
Abilene Oil & Shell Company

330 Ft. from N. Line
____ Ft. from S. Line
330 Ft. from E. Line
____ Ft. from W. Line
1931

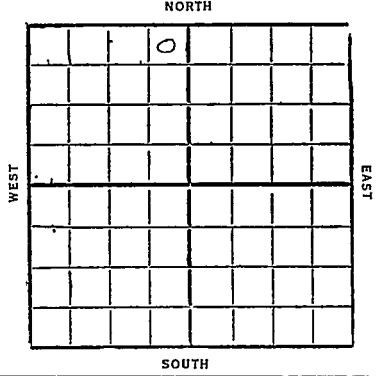

Date	REPORT
4/8	Callar
4/15	Big
4/22	Run up
4/24	drlg 470'
5/6	" 1250'
5/13	" 1490'
5/20	" 2048'
5/27	HFW 2105-2208
	10"-2242
	Drilg 2320'
6/3	" 2370'
6/10	" 2590'
6/17	10"-2315
	Drilg 2858'
6/24	Top Chat 2937
	Show gas 2943
	8"-2943
	2 bails oil at 2955
	HFW 3010' drilg
7/1	Base Chat 3065
	" lime 3158
	5"-3390

7/8- Top Viola 3412' 1st
oil 3414' 2000' oil
at 3416'

T.D. 3425' - Est.

70 bbls per hr.

7/15- T.D. 3426

swab 140 bbl 4 hr

7/22- T.D. 3426

shot 10 qt 3418-25

swab 150 bbl 4 hrs

7/29- Cased 5"-3390

Viola 3412-26

T.D. 3426

shot 10 qt 3418-25

666 bbls oil

potential

Comp.

McPherson

43 KANSAS Sec. *30* Twp. *19* R. *1* *W*

Well No. *1* *Anderson*

Abilene Oil & Shell Company

Contractor

FIRST REPORTS

330 Ft. from N. Line

..... Ft. from S. Line

330 Ft. from E. Line

..... Ft. from W. Line

SECTION PLAT

	0		

Location.....

Rig up *Cellar.*

Drilling and Remarks:

RECORD

Cased..... in., ft.

Sand.....

Gas.....

Oil.....

Total Depth.....

PRODUCTION

1st 24 hrs. Nat.....

1st 24 hrs. after shot.....

Gas..... Cu. Ft.

Dry-Hole.....

Abandoned.....

Date

APR 8 1931

192 **CHAS. L. SHERWOOD** Scout

McPherson

Map No. **KANSAS** Sec. *30* Twp. *19* R. *1* W

Well No. *43* *1* *Anderson*

Abilene Oil & Sheep Company

Contractor

COMPLETE

SECTION PLAT

330 Ft. from N. Line

..... Ft. from S. Line

330 Ft. from E. Line

..... Ft. from W. Line

	0		

Location.....

Rig up.....

Drilling and Remarks:

10/3418-25'

Potential

666 Bls.

RECORD

Cased *5* in., *3390* ft.

Sand *Uola 3412-26*

Gas.....

Oil.....

Total Depth *3426*

PRODUCTION

1st 24 hrs. Nat.....

1st 24 hrs. after shot.....

Gas..... Cu. Ft.

Dry Hole.....

Abandoned.....

Date
JUL 29 1931

CHAS. L. SHERWOOD