Rice


KANSAS

SECTION 3 TOWNSHIP 19S RANGE 6W

WELL NO. #2 Knackstedt "B"

COMPANY Wood River O&G

NORTH NE SE SW

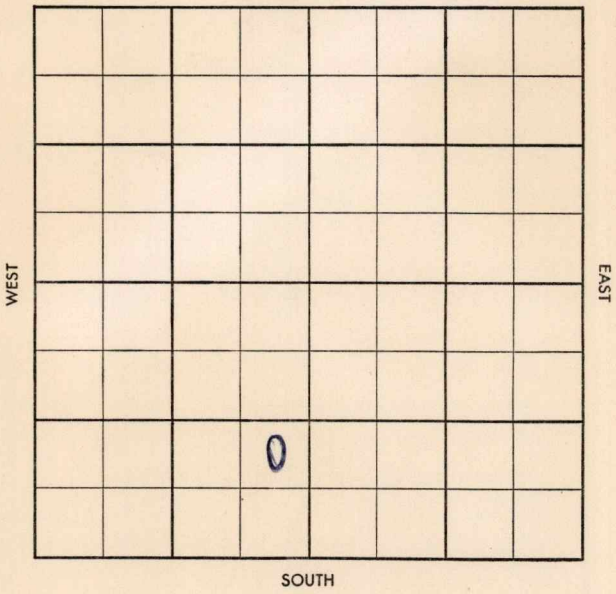

FORM 504-3 SUNRAY

S-513-A

CO. Rice ELEV. 1653 DF

SEC. 3 TWP. 19 RGE. 6W

COMPANY Wood River O & G NO. 2

COMPLETE
FEB 26 '58
0

FARM Knackstedt "B"

LOC. NE SE SW

GEOL. Bob Gill

CONTR. Cherry Drlg. #1

POOL Rellim

SPUD 12/7/57

8" @ 207 w/135, Drlg.

DEC 16 '57

Hb 2579 Dg 2616
Dgsd 2641 BL 2738
L 2778 M 3291 DST
3291-97 60" g/23"
270' oil Nowtr BHP 1120/30"
TD 3297 running csg DEC 26 '57
~~TOOT~~ CO 3297 TD Flowed
1 Bo ph mw nat prep to frac
JAN 2 '58 frac 5000 x 5000
S/20 bbl ph 8 hr. NW TSTM pump
unit JAN 8 '58 x 5" 3291
wo pot JAN 15 '58 P JAN 22 '58 JAN 29 '58
FEB 5 '58 FEB 12 '58 FEB 19 '58 FEB 26 '58 Phy P
149 BO pd NW Miss 3291-97

TD 3297

CO. LSE. NO. SEC. TWP. RGE.

S-513-A

12

FIRST REPORT
DEC 1 1957

CO. Rice ELEV.

SEC. 3 TWP. 19 RGE. 6W

COMPANY Wood River O & G NO. 2

FARM Knackstedt "B"

LOC. NE SE SW

GEOL. Bob Gill

CONTR Cherry Drlg. #1

POOL Rellim

SPUD 12/7/57

8" @ 207 w/125, Drlg. 1500

CO. LSE. NO. SEC. TWP. RGE.