


KANSAS

Rice

Section 5 Township 18 Range 10-W

Well Number #4 ~~#5~~ Habiger

Company Mission Corp.  
~~Bridgeport Machine~~

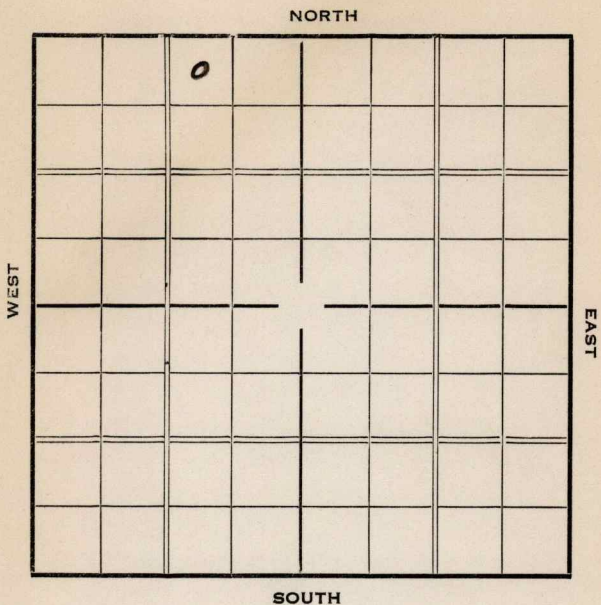

Sec. 5 Twp. 18 R. 10-W


Well No. #3 Habiger #4 Farm  
Mission Corp  
Bridgeport Machine Company

330 Ft. from N. Line

\_\_\_\_\_ Ft. from S. Line

990 Ft. from E. Line

\_\_\_\_\_ Ft. from W. Line

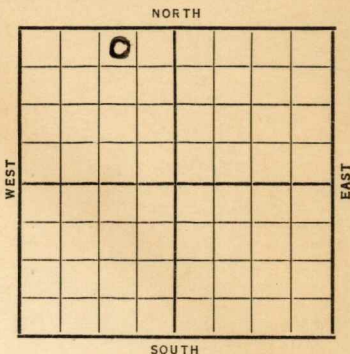

**Elev. 1783**

Date	REPORT
1937	
10/13	CR
10/22	"
10/29	"
11/5	"
11/12	"
11/19	"
11/26	"
12/3	"
12/10	"
12/17	"
12/24	"
12/31	"
1938	
1/7	R. U.
1/14	15" @ 53'. Drlg. 240'.
1/20	12"-600' Drlg. 900'
1/28	<b>Anhy 532'</b> T.D. 1875'
	To Run 10"
2/4	10" -1875' 8" 2340' Drlg. 2475'

**OVER**

1938

2/11 Show gas 2735'.  
Inc. 2820-30'. K.C. 2930'.  
7" @ 2947'. Drlg. 2980'.

2/18 Basal K. C. Pay 3003'.  
Fsg. 3012'.

2/26 T.D. 3014'. 87' of 5" perforate  
liner on bottom. 6000 acid.  
Flowed 1118 oil 1st ~~1~~ 4hrs,  
On potential.

3/2 7" @ 2947'.  
K.C. 2930'.  
Basal K. C. Pay 3003'.  
T.D. 3014'.  
6000 acid.  
Flowed 1118 bbls. in 4 hrs &  
835 bbls. 4 hrs.  
Potential 5008 bbls.  
Gas Gauged  $5\frac{1}{2}$  M 1st 2 hrs &  
 $1\frac{1}{2}$  M last 4 hrs of Potential  
test.

**COMPLETED**

Rice

**KANSAS**

Map No. \_\_\_\_\_ Sec. 5 Twp. 18 R. 10W

Well No. 3 Habiger

Bridgeport Machine Company

FIRST REPORT Contractor

NW NE NW

**SECTION PLAT**

330 Ft. from N. Line

\_\_\_\_\_ Ft. from S. Line

990 Ft. from E. Line

\_\_\_\_\_ Ft. from W. Line

	0		

Location \_\_\_\_\_

**RECORD**

Rig up \_\_\_\_\_

Drilling and Remarks:

CR

Cased \_\_\_\_\_ in., \_\_\_\_\_ ft.

Sand \_\_\_\_\_

Gas \_\_\_\_\_

Oil \_\_\_\_\_

Total Depth \_\_\_\_\_

**PRODUCTION**

1st 24 hrs. Nat. \_\_\_\_\_

1st 24 hrs. after shot \_\_\_\_\_

Gas \_\_\_\_\_ Cu. Ft.

Dry Hole \_\_\_\_\_

Abandoned \_\_\_\_\_

Date

OCT 13 1937 19

H. D. Hatfield Scout

KANSAS

Form 26—1M Bks.—2-29

Rice

Map No. \_\_\_\_\_ Sec. 5 Twp. 18 R. 10W

Well No. 3 Habiger

Bridgeport Machine Co. Company

Contractor

COMPLETED

SECTION PLAT

NW NE NW

330 Ft. from N. Line

\_\_\_\_\_ Ft. from S. Line

990 Ft. from E. Line

\_\_\_\_\_ Ft. from W. Line

	0		

Location \_\_\_\_\_

RECORD

Rig up \_\_\_\_\_

Drilling and Remarks:

6000 Acid

Flowed 1118/4 &

835/4 POT 5008

gas gauged 5 1/2 M

1st 2 hrs & 1 1/2 M last

4 hrs of POT TEST.

Cased 7 in., 2947 ft.

Sand K.C. 2930

Gas Basal K.C. pay 3003

Oil \_\_\_\_\_

Total Depth 3014

PRODUCTION

1st 24 hrs. Nat. \_\_\_\_\_

1st 24 hrs. after shot \_\_\_\_\_

Gas \_\_\_\_\_ Cu. Ft.

Dry Hole \_\_\_\_\_

Abandoned \_\_\_\_\_

Date

MAR 2 - 1938 19

H. D. Hatfield Scout

Rice

KANSAS

Map No. 55 Sec. 5 Twp. 18 R. 10<sup>w</sup>

Well No. 4-Haliger (comp well)

Mission Coys Company

Contractor

NW NE NW

SECTION PLAT

	0		

330 Ft. from N. Line

CORRECTION

\_\_\_\_\_ Ft. from S. Line

990 Ft. from E. Line

\_\_\_\_\_ Ft. from W. Line

CORRECTION

Location \_\_\_\_\_

Rig up \_\_\_\_\_

Drilling and Remarks:

Well Number changed From #3 - To #4

U

RECORD

Cased \_\_\_\_\_ in., \_\_\_\_\_ ft.

Sand \_\_\_\_\_

Gas \_\_\_\_\_

Oil \_\_\_\_\_

Total Depth \_\_\_\_\_

PRODUCTION

1st 24 hrs. Nat. \_\_\_\_\_

1st 24 hrs. after shot \_\_\_\_\_

Gas \_\_\_\_\_ Cu. Ft.

Dry Hole \_\_\_\_\_

Abandoned \_\_\_\_\_

Date

APR 12 1939 19

H. D. Hatfield Scout