

KANSAS

Form 51-5M-11-38-Palace


Rice

Section 5 Township 18 Range 10-W

Well No. #2 Roesler

Company Vickers

NORTH Bloomer Pool

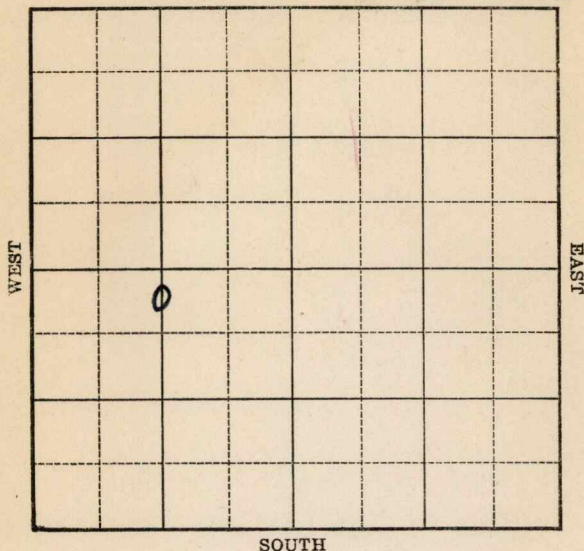

Rice

KANSAS

Map No. 55 Sec. 5 Twp. 18 R. 10WWell No. 2 RoeslerVickers

Company

Contractor

FIRST REPORT

C N L SW

330 Ft. from N. Line


Ft. from S. Line

1320 Ft. from E. Line

Ft. from W. Line

BLOOMER POOL

SECTION PLAT

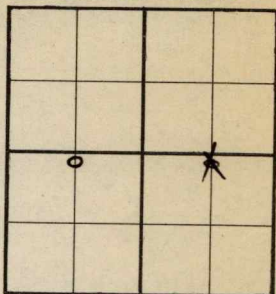

Location _____

Rig up _____

Drilling and Remarks:

Derrick

RECORD

Cased _____ in., _____ ft.

Sand _____

Gas _____

Oil _____

Total Depth _____

PRODUCTION

1st 24 hrs. Nat. _____

1st 24 hrs. after shot _____

Gas _____ Cu. Ft.

Dry Hole _____

Abandoned _____

Date

NOV 1 1939 19

S. J. LEWIS Scout

Map No. 53 Sec. 5 Twp. 18 R. 10WWell No. 2 RoeslerVickers

Company

Contractor

COMPLETED

SECTION PLAT

C N L SW

330 Ft. from N. Line

Ft. from S. Line

1320 Ft. from E. Line

Ft. from W. Line

BLOOMER POOL

Location

Rig up

Drilling and Remarks:

*Cr & 321 1/2**7" @ 321 1/2**Depthograph P & T**7673**Maximum 3000*

RECORD

Cased _____ in., _____ ft.

Sand _____

Gas _____

Oil _____

Total Depth 3214

PRODUCTION

1st 24 hrs. Nat. _____

1st 24 hrs. after shot _____

Gas _____ Cu. Ft.

Dry Hole _____

Abandoned _____

Date

DEC 6 1939 19

S. J. LEWIS Scout