

KANSAS


**Rice County, Kansas
Bloomer Pool**

Form 51-5M-7-39-Palace

Section 5 Township 18 Range 10W

Well No. #3 Habiger "B"

Company Transwestern etal

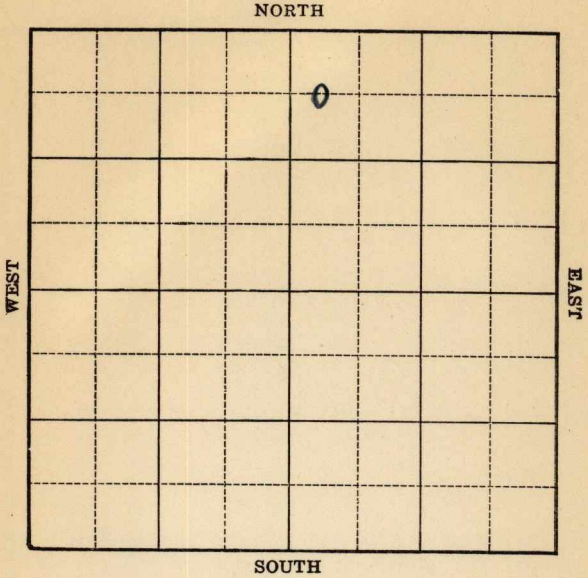

Sec. 5 Twp. 18 R. 10-W

Well No. #3 Habiger "B" Farm

Transwestern et al Company

(Bloomer)


660 Ft. from N. Line

_____ Ft. from S. Line

_____ Ft. from E. Line

330 Ft. from W. Line

Elev. 1774

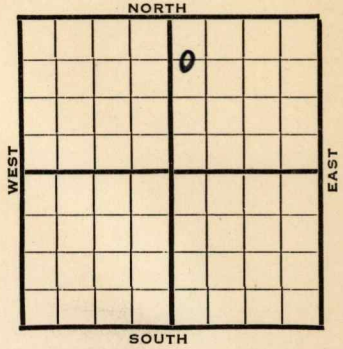

1940		REPORT
6/26	Derrick.	
7/3	10" - 215'	
7/11	Drlg. 2625'	
7/18	Lans. 2925' Arb. 3207-08' T.D.	
	5" - 3208' RUST. S.O.	
7/24	Arb. 3202½'	
	5" - 3202½'	
	T.D. 3242'	
	3000 acid.	
	Depthograph potential 3124 bbls.	
	Maximum 3000 bbls.	

COMPLETED

Map No. 55 Sec. 5 Twp. 18 R. 10W

Well No. 3 Habiger "B"

Transwestern etal Company

Contractor

FIRST REPORT

SECTION PLAT

660 C W L NW NE
Ft. from N. Line

_____ Ft. from S. Line

_____ Ft. from E. Line

330 Ft. from W. Line

		0	

BLOOMER POOL

Location _____

Rig up _____

Drilling and Remarks:

Derrick

RECORD

Cased _____ in., _____ ft.

Sand _____

Gas _____

Oil _____

Total Depth _____

PRODUCTION

1st 24 hrs. Nat. _____

1st 24 hrs. after shot _____

Gas _____ Cu. Ft.

Dry Hole _____

Abandoned 1 _____

Date

JUN 26 1940

19

S. J. LEWIS Scout

Map No. _____ Sec. 5 Twp. 18 R. 10W

Well No. 3 Habiger "B"

Transwestern etal Company

Contractor

COMPLETED

SECTION PLAT

C W L NW NE

660 Ft. from N. Line

_____ Ft. from S. Line

_____ Ft. from E. Line

330 Ft. from W. Line

BLOOMER POOL

Location _____

Rig up _____

Drilling and Remarks:

Cor 73202 1/2

5" @ 3202 1/2

2000 acid

Depthograph

3124

Map 3600

RECORD

Cased _____ in., _____ ft.

Sand _____

Gas _____

Oil _____

Total Depth 3242

PRODUCTION

1st 24 hrs. Nat. _____

1st 24 hrs. after shot _____

Gas _____ Cu. Ft.

Dry Hole _____

Abandoned _____

Date

JUL 24 1940 19

S. J. LEWIS Scout