


Section 10 Township 14 Range 14W

Well No. #5 Newcomer "B"

Company Bennett & Roberts

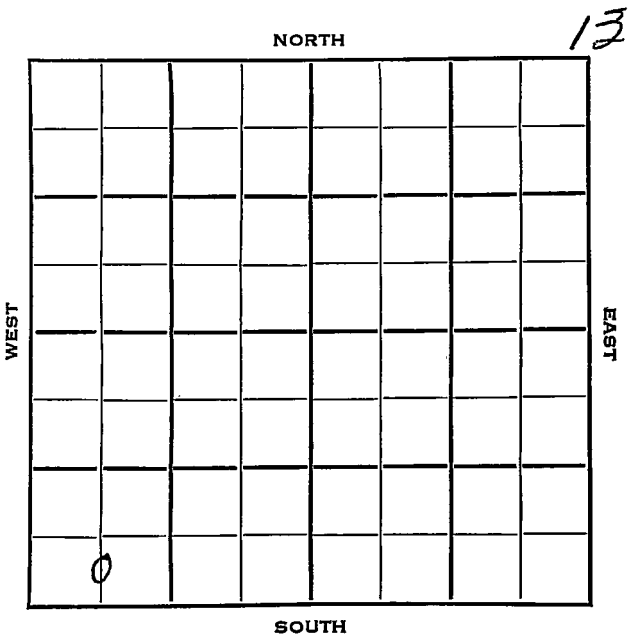

Russell KANSAS

SEC. 10	TWP. 14	R. 11W
------------	------------	-----------

WELL NO. 5 Newcomer "B" FARM

COMPANY Bennett & Roberts

CONTRACTOR B & R Drlg.


all-Gurney Pool

_____ Ft. from N. Line

330 _____ Ft. from S. Line

_____ Ft. from E. Line

660 _____ Ft. from W. Line

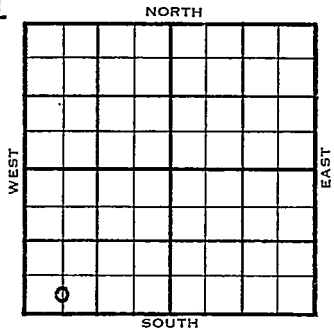

C S L SW SW

	ELEVATION	REPORT
1953	1856'	
12/30	Drlg. 700'	
1954 1/6	10" @ 736' KC 3012' Drlg. 3125'	
1/13	Reagan 3270' DST 3268-81', 1 hr., 240' SW, 1000# DST 3319-30', 1½ hrs., 2200' SW, 1000# Gt.wash 3653' Drlg. 3747' fro SWD	
1/20	NR	
1/27	Spud 12-27-53 SWD well TD 3789 10" @ 736' Top. 2722 KC 3012 Regan 3270 DST 3268-81 open 1 hr rec 240' SW 1000# DST 3319-30 open 1½ hr rec 2200' SW 1000# Gr. wash 3653' TD 3789 7" @ 3490 CO to 3789' Comp. for SWD well	

ABANDONED

County Russell State Kansas

Sec. 10 (Blk. Twp.) 14 (Sur. Rge.) 14W Map No.

Operator Bennett & Roberts

Well No. 5 Farm Newcomer "B"

Elev. 1856 Location C S L SW SW

ABANDONED

330 Ft. From S Line SW

660 Ft. From $\frac{1}{4}$ Line Quarter

1st. Report

Completion JAN 27 1954

Remarks Hall-Gurney Pool

B & R Drlg. - Contr.

Spudding Date 12-27-53

Drlg. Data SWD well TD 3789

10" @ 736 Top. 2722 KC 3012

Regan 3270 DST 3268-81 open 1 hr.

Rec. 240' sw 1000# DST 3319-30

open 1 $\frac{1}{2}$ hr. Rec. 2200' sw 1000#

Gr. wash 3653 TD 3789 7" @ 3490

CO to 3789 Comp. for SWD well