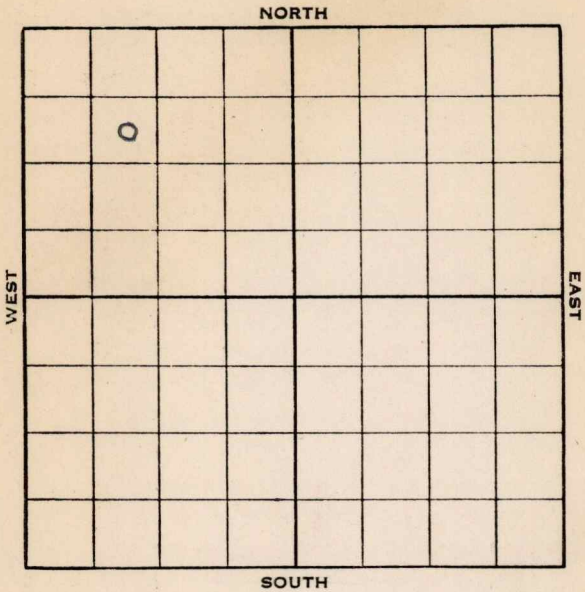


Rice


Section 5 Township 18 Range 10WWell No. #5 ~~X~~ HabigerCompany Mission Corp
Bridgeport et al

KANSAS

Rice

Sec. 5 Twp. 18 R. 10-WWell No. #7 Habiger #5 Farm
Mission Corp
Bridgeport et al Company990 Ft. from N. Line Ft. from S. Line Ft. from E. Line990 Ft. from W. Line

Elev. 1789'.

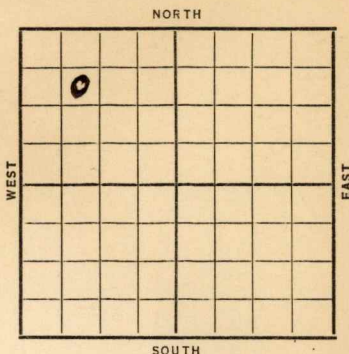

Date

REPORT

1938

2/9

Digging cellar.

2/18

C. R.

2/26

"

3/4

R. U.

3/11

15" @ 72'. Anhy 535'.

13" @ 539'. WOC.

3/18

Drlg. 1490'.

3/25

8" @ 1875'. Drlg. 2035'.

4/1

8" @ 2274'. Drlg. 2685'.

4/8

10" @ 1870'. S.G. 2735'.

Inc. 2835'. 7" @ 2980'.

Drlg. 2998'.

4/15

Pay 3003-15' T.D. 7" @ 3003'.

Cleaning out.

OVER

1938

4/20

7" @ 3007'.

K.C. 2920'.

T.D. 3019'.

6000 acid.

Flowed 686 bbls. 4 hrs. &

596 bbls. 4 hrs.

Potential 3577 bbls.

Estimate 11 M gas.

COMPLETED

Rice

KANSASMap No. _____ Sec. 5 Twp. 18 R. 10WWell No. 7 HabigerBridgeport ET&I Company

Contractor _____

FIRST REPORT**SE NW NW**990 Ft. from N. Line

_____ Ft. from S. Line

_____ Ft. from E. Line

990 Ft. from W. Line**SECTION PLAT**

0			

Location _____

Rig up _____

Drilling and Remarks:

Digging Cellar**RECORD**

Cased _____ in., _____ ft.

Sand _____

Gas _____

Oil _____

Total Depth _____

PRODUCTION

1st 24 hrs. Nat. _____

1st 24 hrs. after shot _____

Gas _____ Cu. Ft.

Dry Hole _____

Abandoned _____

Date

FEB 9 1938H. D. Hatfield

Scout

KANSAS

Map No. 55 Sec. 5 Twp. 18 R. 10 ^WWell No. 5-Habiger (comp well)Mission Corp Company

Contractor

SECTION PLAT

0			

990 Ft. from N. Line

Ft. from S. Line

Ft. from E. Line

990 Ft. from W. Line

Location _____

Rig up _____

Drilling and Remarks:

Well numbers
changed from
7 To # 5

RECORD

Cased _____ in., _____ ft.

Sand _____

Gas _____

Oil _____

Total Depth _____

PRODUCTION

1st 24 hrs. Nat. _____

1st 24 hrs. after shot _____

Gas _____ Cu. Ft.

Dry Hole _____

Abandoned _____

Date

APR 12 1939

19

H. D. Hatfield

Scout

Rice **KANSAS**Map No. 55 Sec. 5 Twp. 18 R. 10WWell No. 7 HabigerBridgeport etal

Company

Contractor

COMPLETED

SE NW NW

SECTION PLAT990 Ft. from N. Line Ft. from S. Line Ft. from E. Line990 Ft. from W. Line

o			

Location Rig up

Drilling and Remarks:

6000 andFlowed
686/4 + 596/4POT 3577EST 11M gas**RECORD**Cased 7 in., 3007 ft.Sand KC, 2920Gas Oil Total Depth 3019**PRODUCTION**1st 24 hrs. Nat. 1st 24 hrs. after shot Gas Cu. Ft.Dry Hole Abandoned

Date

APR 20 193819H. D. Hatfield

Scout