

Section 5 Township 18 Range 10W

Well No. 5 Roessler

Company Vickers

Bloomer Pool

NORTH

WEST

EAST

0							

SOUTH

Sec. 5 Twp. 18 R. 10W

Well No. #5 Roessler Farm


Vickers Company
Bloomer

 Ft. from N. Line

990 Ft. from S. Line

 Ft. from E. Line

330 Ft. from W. Line

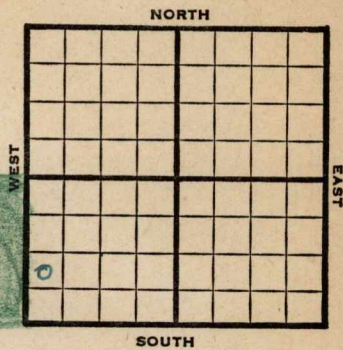

NW SW SW

SOUTH

1947

Elev. 1776' REPORT

- 10/15 10" @ 240'
WOC
- 10/22 Drlg. 2700'
- 10/29 **Lansning 2938'**
Arbuckle 3238'
TD 3280'
7" @ 3280'
RUST
- 11/4 "
- 11/12 PB 3258'
11 shots. 3234-38½ no show.
24 shots 3242-50' - 250' oil 14 hrs.
1000 acid, 2800' W 18 hrs.
Squeeze
Perf. 36 shots. 2962-70'
500 acid. no help
squeeze.
- 11/19 "
- 11/25 "
- 12/3 **Arbuckle 3238'**
7" @ 3280'
SWD
Total Depth 3280'

ABANDONED

Map No. _____ Sec. 5 Twp. 18 R. 10W

Well No. 5 Roessler

Vickers Company

FIRST REPORT Contractor

NW SW SW

SECTION PLAT

_____ Ft. from N. Line

990 Ft. from S. Line

_____ Ft. from E. Line

330 Ft. from W. Line

Rice County

Location _____

Rig up _____

Drilling and Remarks:

10" @ 240 WOC

RECORD

Cased _____ in., _____ ft.

Sand _____

Gas _____

Oil _____

Total Depth _____

PRODUCTION

1st 24 hrs. Nat. _____

1st 24 hrs. after shot _____

Gas _____ Cu. Ft.

Dry Hole _____

Abandoned _____

Date

OCT 15 1947

19

S. J. LEWIS

Scout

