

Rice


DX 78-1

KANSAS

Section 24 Township 19 Range 6W

Well No. #1 Swanson

Company Oil Trading Co.

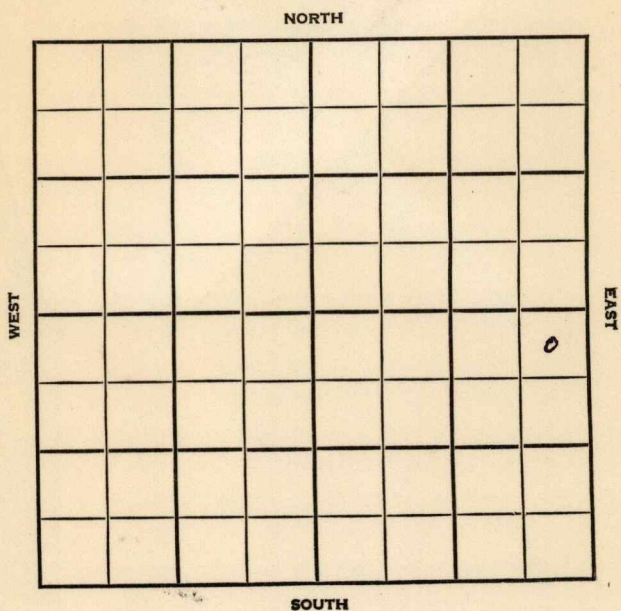

Rice

KANSAS

| | | |
|------|------|-----|
| SEC. | TWP. | R. |
| 24 | 19 | 6 W |

WELL NO. _____

COMPANY # 1 Swanson FARM

CONTRACTOR Oil Trading Co.


Trans-Era
Wildcat

330 _____ Ft. from N. Line

_____ Ft. from S. Line

330 _____ Ft. from E. Line

_____ Ft. from W. Line

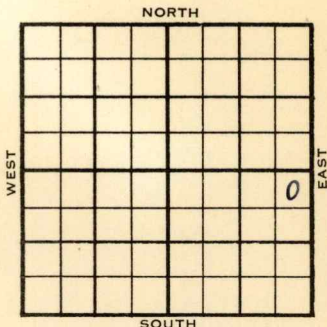

NE NE SE

Texas FO

ELEVATION

REPORT

1954

1624'

12/22

Spud 12-19-54
8" @ 177
Drlg. 935'

1955
2/23

Spud 12-19-54 - Oil Well
TD 3455'
8" @ 177'
Heeb. 2585', Br lime 2776', Lans.
2797', Cong. 3409'
DST 3410-16', opn 1 hr., gas in 55",
rec. 60' HO&GCM, 285' gassy oil, 15'
wtr., 810#
Miss. 3435'
TD 3439'
5" @ 3436'
DD 3455', SSO 95% wtr., 500 M-A
PB 3430'
36/3412-18,
S/ .84 boph frac
S/4 1/2 boph 8 hrs.
P/58 bo 2 bw 24 hrs.
P/60 bopd
Comp. 47 bopd 21% wtr.

COMPLETED

