


Section 4 Township 14 Range 14-W

Well No. #3 Krug

Company Coralena

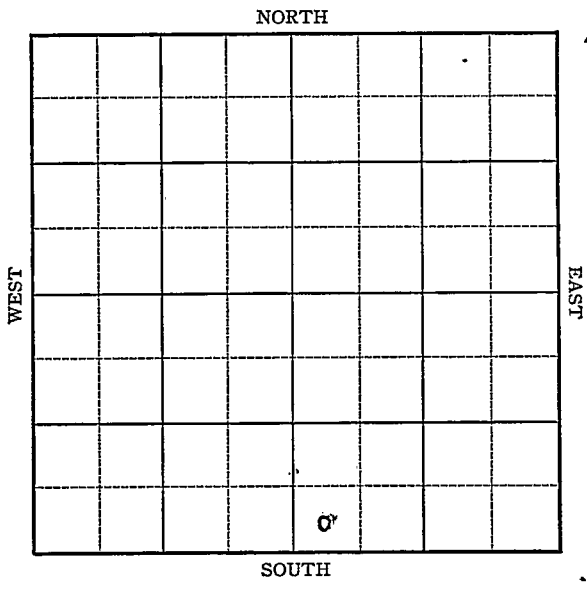

KANSAS

Russell

Sec. 4 Twp. 14 R. 14 ~~W~~

Well No. #3 Krug Farm

Coralena Company


Witt

 Ft. from N. Line

330 Ft. from S. Line

 Ft. from E. Line

330 Ft. from W. Line

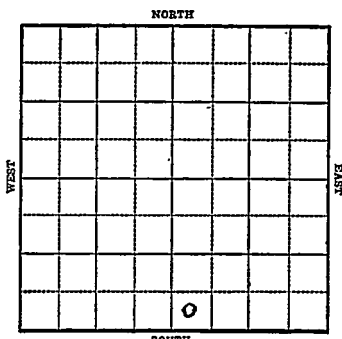

Elev. 1862

1943

R E P O R T

6/8 Cellar

6/16 "

6/23 "

6/30 "

7/7 "

7/15 "

7/21 "

7/28 "

8/4 "

8/11 "

8/18 "

8/25 10" @ 150'
Drlg. 1200'

9/1 2893' fsg.

9/8 Topeka 2715
Dodge 2985
Lan. 3025
T.D. 3060
7" @ 3047
Rust

OVER

1943

9/15 2000 acid 400' oil in 12 hrs.

9/22 Lans 3025
7" @ 3047
2000 acid
Pump 227 Pot.
Gravity 40.4
T.D. 3060'

COMPLETED

Russell

KANSAS


Map No. 72 Sec. 4 Twp. 14 R. 14WWell No. 3 KrugCoralena Company

FIRST REPORT Contractor

SW SE

 Ft. from N. Line330 Ft. from S. Line Ft. from E. Line330 Ft. from W. Line

SECTION PLAT

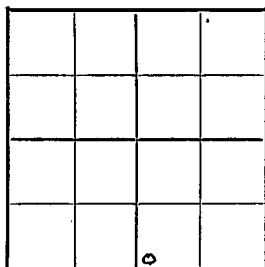

WITT POOL

Location Rig up

Drilling and Remarks:

Cell ar

RECORD

Cased in., ft.Sand Gas Oil Total Depth

PRODUCTION

1st 24 hrs. Nat. 1st 24 hrs. after shot Gas Cu. Ft.Dry Hole Abandoned

Date

JUN 9 1943 19S. J. LEWIS Scout

KANSAS
 Map No. 725 Sec. 4 Twp. 14 R. 14W

Well No. 3 Krug

Corelena Company

COMPLETED

Contractor

SW SE


SECTION PLAT

_____ Ft. from N. Line

330 Ft. from S. Line

_____ Ft. from E. Line

330 Ft. from W. Line

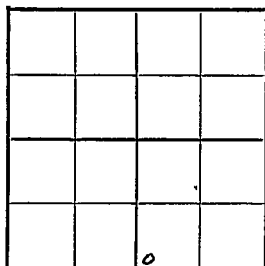

Witt Pool

Location _____

Rig up _____

Drilling and Remarks:

Lane 3025

7" @ 3047

2000 @ 3060

Pump 227 P. X.

40 4/4

RECORD

Cased _____ in., _____ ft.

Sand _____

Gas _____

Oil _____

Total Depth 3060

PRODUCTION

1st 24 hrs. Nat. _____

1st 24 hrs. after shot _____

Gas _____ Cu. Ft.

Dry Hole _____

Abandoned _____

Date

SEP 22 1943 19 S. J. LEWIS Scout