


KANSAS

Section 13 Township 19 Range 6W

Well No. 1 Green Est.

Company Cardinal Oil et al

Bornholdt Pool

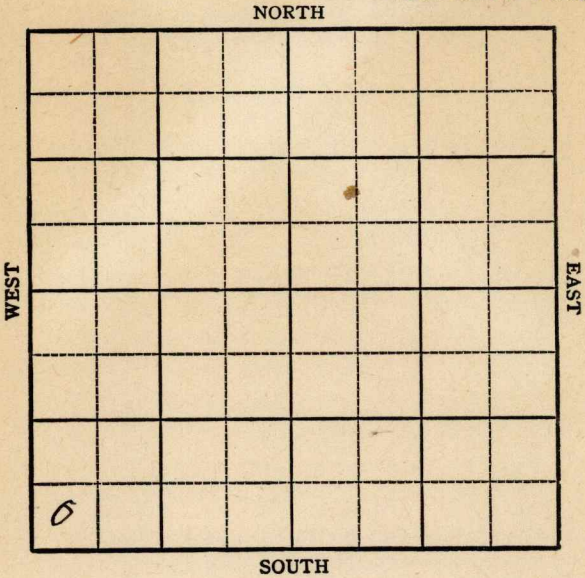

**KANSAS**

Rice

Sec. 13 Twp. 19 R. 6W ✓

Well No. #1 Green Est. Farm \_\_\_\_\_

Cardinal Oil et al Company

Bornholdt Pool


\_\_\_\_\_ Ft. from N. Line

330' Ft. from S. Line

\_\_\_\_\_ Ft. from E. Line

330' Ft. from W. Line

SW/C

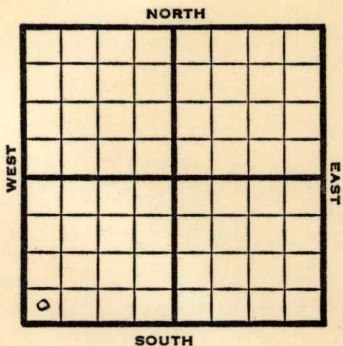

1948

**Eli 1592'**

R E P O R T

11/10

8" @ 152'  
Drlg. 1785'

11/16

**Miss 3399'**  
5" @ 3405'  
TD 3413'

11/23

"

12/1

TD 3427'  
**Miss 3399'**  
5"@ 3405'  
Aband.

**ABANDONED**

Kansas

Map No. \_\_\_\_\_ Sec. 13 Twp. 19 R. 6W

Well No. 1 Green Est.

Cardinal Oil etal. Company

FIRST REPORT Contractor

SW/C

SECTION PLAT

\_\_\_\_\_ Ft. from N. Line

330 Ft. from S. Line

\_\_\_\_\_ Ft. from E. Line

330 Ft. from W. Line


Rice County

Location \_\_\_\_\_

Rig up \_\_\_\_\_

Drilling and Remarks:

8" @ 152

drlg. 1785

RECORD

Cased \_\_\_\_\_ in., \_\_\_\_\_ ft.

Sand \_\_\_\_\_

Gas \_\_\_\_\_

Oil \_\_\_\_\_

Total Depth \_\_\_\_\_

PRODUCTION

1st 24 hrs. Nat. \_\_\_\_\_

1st 24 hrs. after shot \_\_\_\_\_

Gas \_\_\_\_\_ Cu. Ft.

Dry Hole \_\_\_\_\_

Abandoned \_\_\_\_\_

Date

NOV 10 1948

19

S. J. LEWIS

Scout

