


Section 16 Township 19 Range 6W

Well No. #1 Alton

Company L. B. Jackson

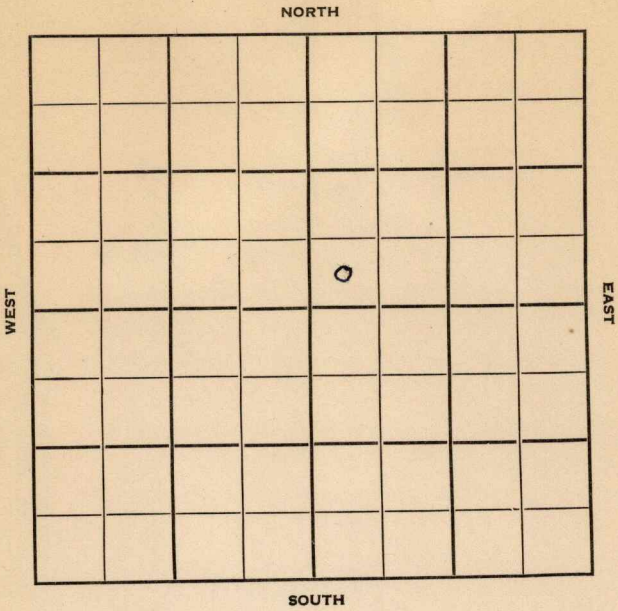

Rice

KANSAS ✓

Sec. 16 Twp. 19 R. 6W

Well No. #1 Alton Farm

L. B. Jackson Company

Contractor

Wildcat

Ft. from N. Line


330 Ft. from S. Line

Ft. from E. Line

330 Ft. from W. Line

NE $\frac{1}{4}$ SW SW NE

Amerda & Phillips support

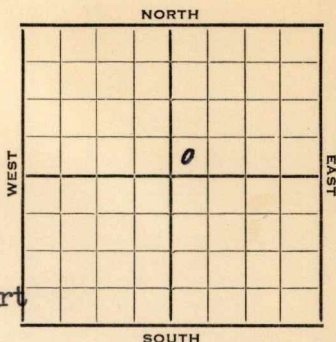

1952

Elev. 1587'

REPORT

10/22 Location

10/29 8" @ 194'

Topeka 2232', Heeb 2516', Tor 2538',
Douglas 2550', Br. Li 2674', Lans
2702'

DST 3010-31

11/5 Spud 10-18-52

D&A TD 3576 8" @ 194

Top. 2232 Heeb. 2516

Tor. 2538 Doug. 2550

Br Li 2674 Lans. 2702

DST 3010-31 open 1 hr. rec. 25' mud
12#

DST 3038-57 open 1 $\frac{1}{2}$ hr. rec. 185' sw
1020#

B KC 3071 Misener 3390

Viola 3426 Simp. dol. 3472

Simp. sd. 3514 Arb. 3538

TD 3576' D&A

ABANDONED

