KANSAS

Form 51—5M—7-39—Palace


Rice

Section 23 Township 19 Range 6-W

Well No. #1 Bean

Company Republic & Bradley

Wildcat

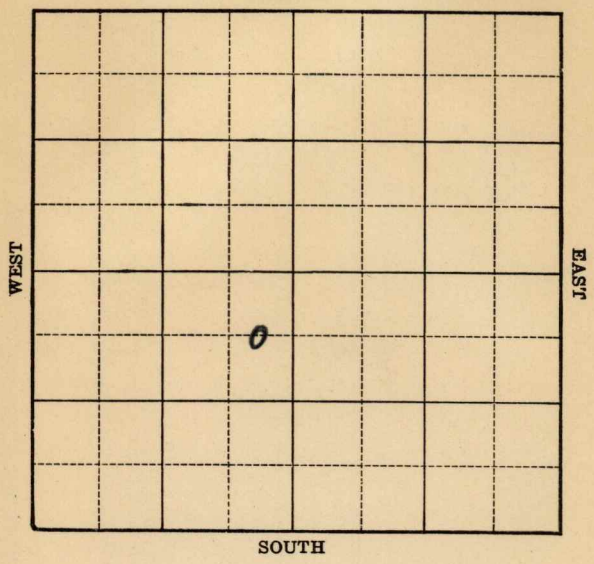

FORM 252-A 5M 2-40

KANSAS Rice

Sec. 23 Twp. 19 R. 6-W

Well No. #1 Bean Farm

Republic & Bradley Company

(Wildcat)


660 Ft. from N. Line

Ft. from S. Line

330 Ft. from E. Line

Ft. from W. Line

Elev. 1598

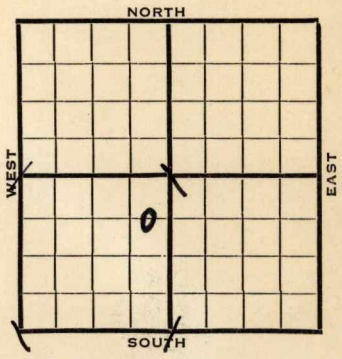

1940	REPORT
6/19	Derrick.
6/25	Dlg. 760 (Tel)
6/27	10" - 128'
	Drlg. 760'
7/3	Lansing 2742' Drlg. 2960'
7/6	Chat 3238 T.D. 3254
	Good saturation and free oil in
	cuttings (Telegram)
7/11	Chat. 3238' S.O. 3238-54'
	B. Chat. 3272-99' T.D.
	6" - 3238'
7/17	Chat. 3238'
	6" - 3238'
	B. Chat. 3272'
	Kinderhook 3277'
	T.D. 3299' Water.
	COMPLETED

KANSAS

Form 26—200 Bks.—1-40—Palace Rice

Map No. 48 Sec. 23 Twp. 19 R. 6W

Well No. 1 Bean

Republic & Bradley Company

Contractor

FIRST REPORT

C E L NE SW

660 Ft. from N. Line


Ft. from S. Line

330 Ft. from E. Line

Ft. from W. Line

WILDCAT

SECTION PLAT

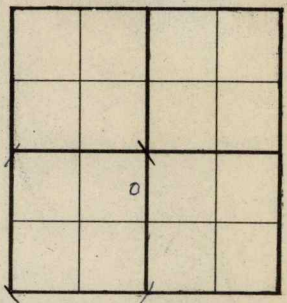

Location

Rig up

Drilling and Remarks:

Derrick

RECORD

Cased in., ft.

Sand

Gas

Oil

Total Depth

PRODUCTION

1st 24 hrs. Nat.

1st 24 hrs. after shot

Gas Cu. Ft.

Dry Hole

Abandoned

Date

JUN 19 1940 19

S. J. LEWIS Scout

Form 26—200 Bks.—1-40—Palace Rice KANSAS

Map No. 48 Sec. 23 Twp. 19 R. 6W

Well No. 1 Bean

Republic & Bradley Company

Contractor

ABANDONED

C E L NE SW

660 Ft. from N. Line


Ft. from S. Line

330 Ft. from E. Line

Ft. from W. Line

WILDCAT

SECTION PLAT

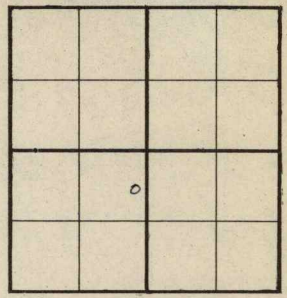

Location

Rig up

Drilling and Remarks:

Cha 3238.

6" @ 3238

B. Cha 3272.

Kinderhook 3277

Water.

RECORD

Cased in., ft.

Sand

Gas

Oil

Total Depth 3299

PRODUCTION

1st 24 hrs. Nat.

1st 24 hrs. after shot

Gas Cu. Ft.

Dry Hole

Abandoned

Date

JUL 17 1940 19

S. J. LEWIS Scout