
KANSAS Rice

FORM 51 5M PETROL

Section 23 Township 19 Range 6W

Well No. #2 Allison

Company Nelson Drlg.

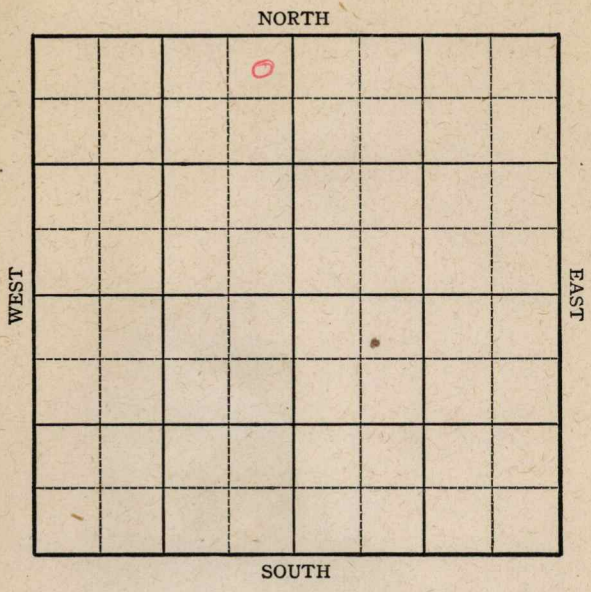

FORM 252-A
5M 3-45 PETROL

KANSAS

Rice

Sec. 23 Twp. 19 R. 6-W

Well No. ~~#1~~ #2 Allison Farm

Nelson Drlg. Company


330 Ft. from N. Line

_____ Ft. from S. Line

_____ Ft. from E. Line

990 Ft. from W. Line

NE NW NE

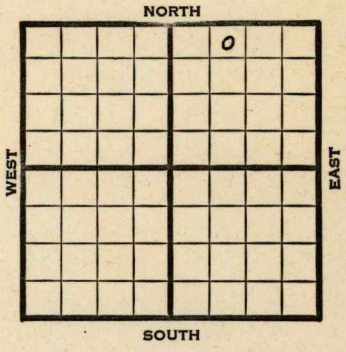

1945	REPORT
	~~Elev. 1619~~
7/18	RUR
7/26	Lans 2741
	Chat 3310
	TD 3320
	5" @ 3310' RUST
8/15	Miss. 3310
	5" @ 3310
	TD 3393'

ABANDONED

FORM 26 200 BKS 1-44 PETROL

Pool Name Bornholdt

Kansas

Map No. 48 Sec. 23 Twp. 19 R. 6W

Well No. #2 Allison

Nelson Drlg. Company

CORRECTION Contractor

NE NW NE


330 Ft. from N. Line

Ft. from S. Line

Ft. from E. Line

990 Ft. from W. Line

SECTION PLAT

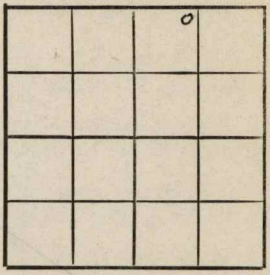

Rice County

Location

Rig up

Drilling and Remarks:

reported as

#1 Allison

RECORD

Cased in., ft.

Sand

Gas

Oil

Total Depth

PRODUCTION

1st 24 hrs. Nat.

1st 24 hrs. after shot

Gas Cu. Ft.

Dry Hole

Abandoned

Date

JUL 25 1945 19

S. J. LEWIS Scout

FORM 26 200 BKS. 1-44 PETROL

KANSAS Kansas

Pool Name Bornholdt

Map No. 48 Sec. 23 Twp. 19 R. 6W


Well No. 1 Allison

Nelson Drlg. Company

FIRST REPORT Contractor

NE NW NE

SECTION PLAT

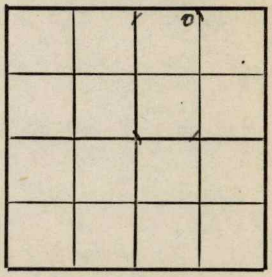

330 Ft. from N. Line

Ft. from S. Line

Ft. from E. Line

990 Ft. from W. Line

Rice County

Location

Rig up

Drilling and Remarks:

RUR

RECORD

Cased in., ft.

Sand

Gas

Oil

Total Depth

PRODUCTION

1st 24 hrs. Nat.

1st 24 hrs. after shot

Gas Cu. Ft.

Dry Hole

Abandoned

Date

JUL 1 8 1945 19

S. J. LEWIS Scout

FORM 26 200 BKS 1 44 PETROL

Kansas Pool Name Bornholdt

KANSAS

Map No. 78 Sec. 23 Twp. 19 R. 6W

Well No. 2 Allison


Nelson Drlg. Company

ABANDONED Contractor

NE NW NE

E.1619

SECTION PLAT

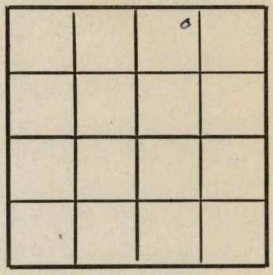

330 Ft. from N. Line

Ft. from S. Line

Ft. from E. Line

990 Ft. from W. Line

Rice County

Location

Rig up

Drilling and Remarks:

Miss 3310

5" C 3310

RECORD

Cased in., ft.

Sand

Gas

Oil

Total Depth 3388

PRODUCTION

1st 24 hrs. Nat.

1st 24 hrs. after shot

Gas Cu. Ft.

Dry Hole

Abandoned

Date

AUG 15 1945 19 S. J. LEWIS Scout