

Section 25 Township 19 Range 6-W

Well No. #2 Anderson


Company Westgast-Greenland

Smyres Pool

NORTH

WEST

EAST

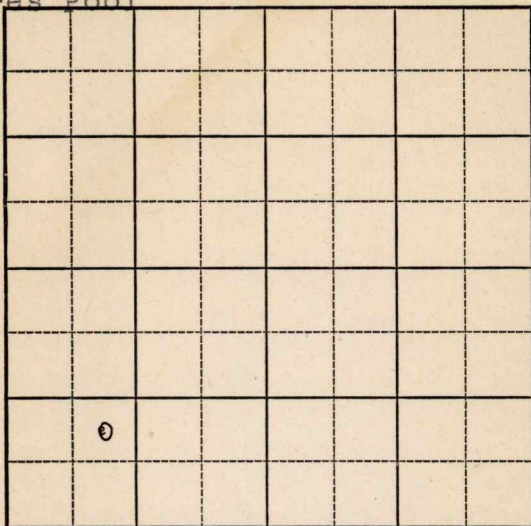

SOUTH

Sec. 25 Twp. 19 R. 6W

Well No. 2-Anderson Farm

Westgate-Greenland

Company


(Smyres pool)

Ft. from N. Line

990 Ft. from S. Line

Ft. from E. Line

990 Ft. from W. Line

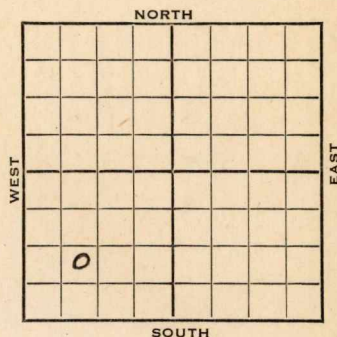

Elev. 1572'

1942

REPORT

9/30 Dlg. 1234 10" 132

10/7 Drlg. 3210'

10/14 Chab. 3302 7" @ 3303

TD 3343

800' oil plus 100' water in 8 hr

10/21 pump 40' oil & water.

10/28 Chat. 3302

7" - 3303

T.D. 3343

Pump 239 oil and 25 water Pot.

Gravity. 37.

COMPLETED

KANSAS


Map No. 4P Sec. 25 Twp. 19 R. 6WWell No. 2 AndersonWestgate-Greenland

Company

Contractor

NE SW SW

SECTION PLAT

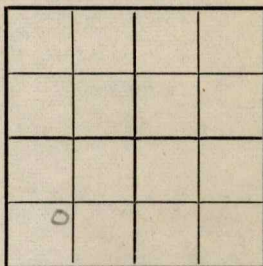

_____ Ft. from N. Line

990

_____ Ft. from S. Line

_____ Ft. from E. Line

990

_____ Ft. from W. Line

SMYRES POOL

Location _____

Rig up _____

Drilling and Remarks:

Only 1234

RECORD

Cased 10 in., 132 ft.

Sand _____

Gas _____

Oil _____

Total Depth _____

PRODUCTION

1st 24 hrs. Nat. _____

1st 24 hrs. after shot _____

Gas _____ Cu. Ft.

Dry Hole _____

Abandoned _____

Date

FIRST REPORTS

SEP 30 1942 19

S. J. LEWIS

Scout

We show Nelson drilled #1 well.


Did Westgate-Greenland take over this lease

Don Schumaker

Company

Contractor

SECTION PLAT

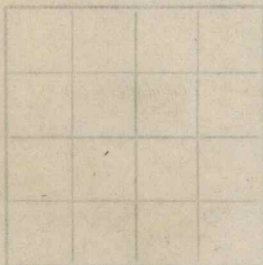

ft. from N. line

ft. from S. line

ft. from E. line

ft. from W. line

SMYRES POOL

RECORD

Location

Rig up

Drilling and Remarks

Misc. Small Maps

Cards

Tracing

France Map

Scarborough Map

Moody Map

Geological Dept.

Moody Flat Book


Date

Scout

Map No. 48 Sec. 25 Twp. 19 R. 6WWell No. 2 AndersonWestgate Greenland CompanyCOMPLETED Contractor

NE SW SW

SECTION PLAT

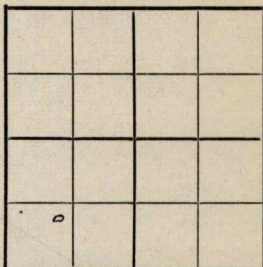 Ft. from N. Line990 Ft. from S. Line Ft. from E. Line990 Ft. from W. Line

SMYRES POOL

Location Rig up

Drilling and Remarks:

Chas 8302.7 " @ 8303Pump 239 oil +
25 Water P &.370 Gr

RECORD

Cased in., ft.Sand Gas Oil Total Depth 3343

PRODUCTION

1st 24 hrs. Nat. 1st 24 hrs. after shot Gas Cu. Ft.Dry Hole Abandoned

Date

OCT 28 1942 19

S. J. LEWIS

Scout

Nekeoa does all the shipping for Westgate-
Greenland and has some interest in the
Company.

They start 100 of leases under Nekeoa
and if producers @ range to Westgate-Greenland.
Sandy